


JACKSON COUNTY - U.S. PUBLIC LAND SURVEY MONUMENT RECORD

TYPE OF MONUMENT Berntsen cast aluminum
 REFERENCED FOR SURVEY RECORDED IN CSM# 1931 or CSR# _____
 SURVEYOR'S FILE # or PROJECT # 99M26
 DRAWN BY K. Salvesson

CORNER VOL. _____ PAGE # 2
 CORNER # 21906360020
 SECTION 36 T. 19 N. R. 6W

GEOGRAPHIC LOCATION:

LATT: _____ ° _____ ' _____ " COUNTY COORDINATE SYSTEM (TO BE ASSIGNED BY COUNTY)
 LONG: _____ ° _____ ' _____ " N = _____
 ELLIPSOID HEIGHT _____ in _____ ft. E = _____
 ORTHO HEIGHT _____ m _____ ft.
 Estimated height accuracy ± _____

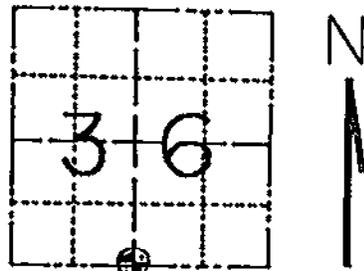

LOCATION (INDICATE W/ MONUMENT SYMBOL)

BASIS FOR MONUMENT LOCATION

Please describe if this is a found, obliterated or lost corner. Give a complete history of the corner listing the vol. & page, dates, surveyor and description of found monument. Please list all parole testimony and who provided it as well as other witness' of recovery. Please describe the best way to reach this corner. Indicate how obstructed this monument might be for GPS observations. Continue on backside if necessary.

We found the cor. mon. in place but the top had been broken off. This corner had been referenced by LaCrosse Cnty. in 1986. The P-K nails used were not visible; the trees having grown over them. The same trees were used for the new references plus one new tree.

A wood post was set here in the original government survey. Clayton Solberg indicates he set a pipe on the E-W fenceline for this corner in 1978. In 1984 R. Berg also set a pipe on the fenceline for this corner. R. Chalsma used Berg's pipe later in 1984. N. Hurlburt used the corner in 1985. Bill Jung, working for LaCrosse County, replaced the pipe with the Berntsen cast alum. monument in 1986. J. Ellingson used to corner in 1989. The corner is now in a junk yard. The E-W fenceline is down in the area of the corner.

South of the corner is tall trees with scattered trees to the north. GPS observations directly on the corner could be difficult.

SEAL:




CERTIFIED CORRECT AND COMPLETE TO THE BEST OF MY KNOWLEDGE AND BELIEF:

Dennis W. Melichar
 Registered Land Surveyor
 DATE: 6/17/99

TIE SKETCH


Show at least four ties. Show fence lines-roads-topo features-size and type of witness trees-trails if available.

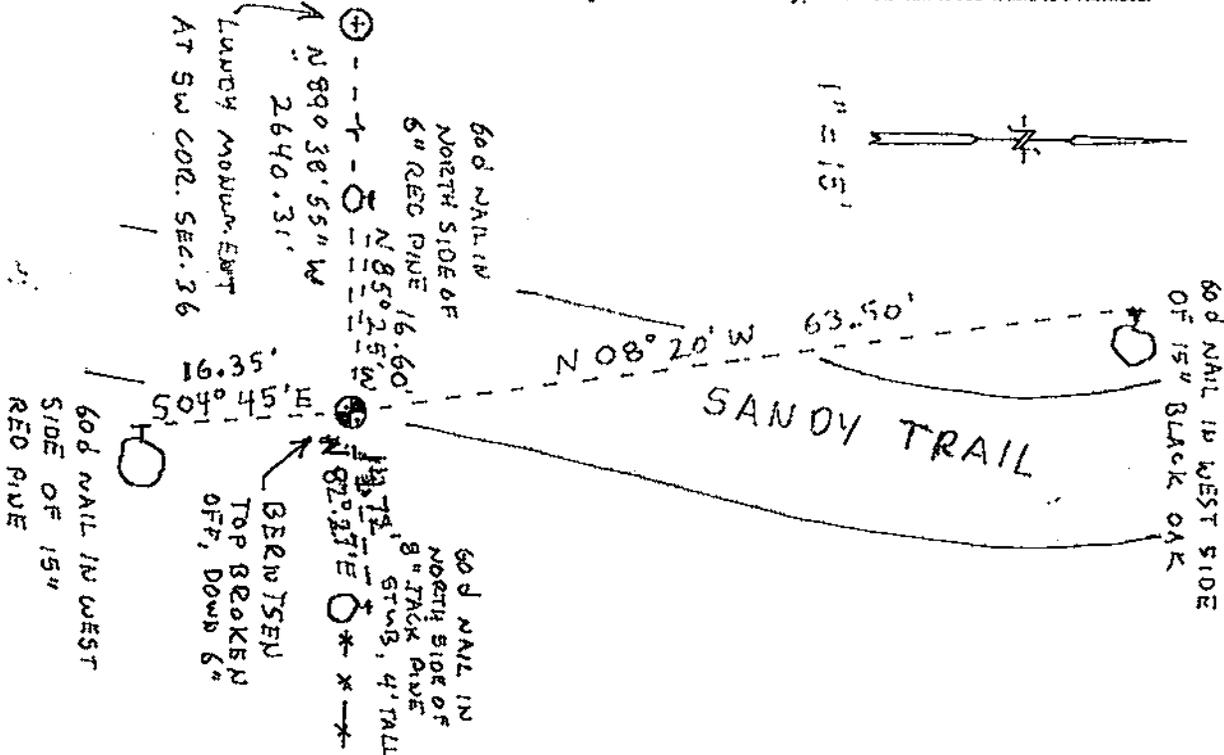

U. S. PUBLIC LAND SURVEY MONUMENT RECORD

SECTION 1 T 18 N, R 6 W, TOWN OF FARMINGTON

LA CROSSE COUNTY

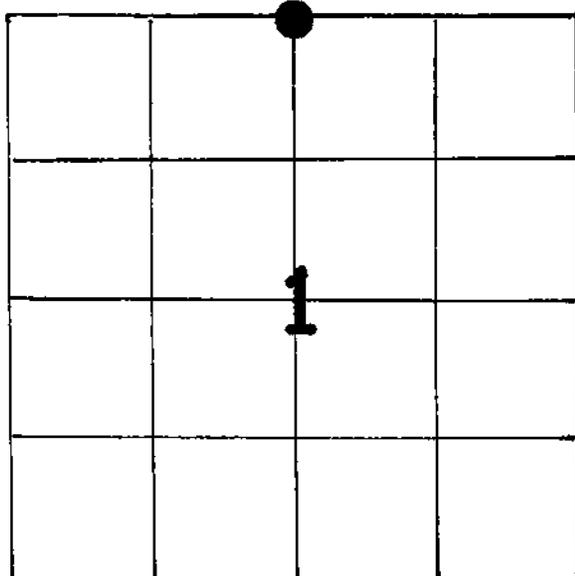

LOCATION OF LANDMARK

Crew: William Jung
Perry Dahl

8/14/85

WISCONSIN COORDINATE SYSTEM

North

East

Theta Angle

Horiz. Order

Vert. Order

TYPE OF LANDMARK

BERNTSEN

BEARINGS ARE REFERENCED TO

Describe any record evidence, monument evidence, testimonial evidence or any other material evidence you considered and whether the monument was found or restored through acceptance of an obliterated evidence location.

Dick Berg set a 1" iron pipe at this corner in March of 1984. Bob Chalsma used the pipe for a survey in April of 1984. Norm Hurlburt used this pipe in April of 1985. I removed the pipe and replaced it with a Berntsen monument


Describe or show any material discrepancy between the location of the restored corner and that of the corner previously restored or reestablished.

None known.

RECORD OF DURABLE WITNESS MONUMENTS

NO	DESCRIPTION	BEARING	DISTANCE
1	P.K. NAIL IN 8" DOUBLE-BLAZED OAK	N10°W = Mag.	63.75'
2	P.K. NAIL IN 10" UNBLAZED NORWAY PINE	S9°E = Mag.	16.29'
3	IRON PIPE (Found)	Assumed= N89°22'40"E	? 198.34'
4	P.K. NAIL IN 7" DOUBLE-BLAZED JACK-PINE	N81°E = Mag.	14.84'

(P.K. nails are in hacks)

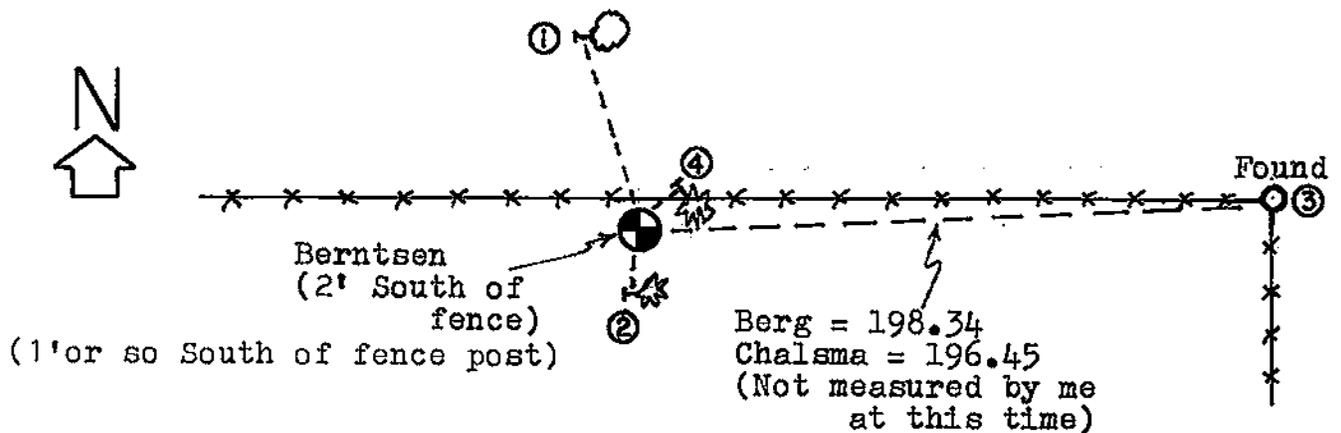

PLAN VIEW DRAWING OF REFERENCE TIES

MAP SHOWING DISTANCE AND DIRECTION TO OTHER PUBLIC LAND SURVEY CORNERS USED FOR REESTABLISHING THE CORNER


None measured by me at this time. See recorded maps by Berg, Chalsma, and Hurlburt.

I, William C. Jung, Deputy County Surveyor
 HEREBY CERTIFY THAT THE CORNER LOCATION SHOWN ON THIS RECORD
 WAS DETERMINED BY ME OR UNDER MY DIRECTION AND CONTROL AND
 THAT THIS U. S. PUBLIC LAND SURVEY MONUMENT RECORD IS CORRECT
 AND COMPLETE TO THE BEST OF MY KNOWLEDGE AND BELIEF.

William C. Jung
 Signature

2/6/86
 Date

Revised: 1/8/90 *WJ*

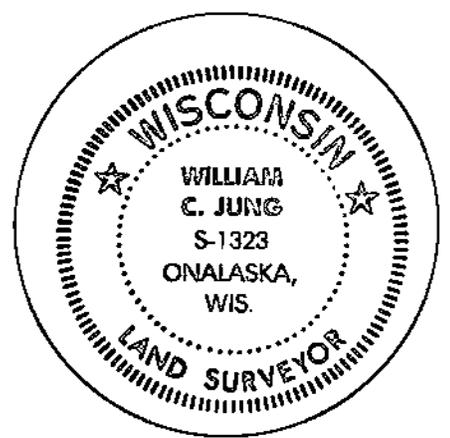

Seal