


21807010000

## U. S. PUBLIC LAND SURVEY MONUMENT RECORD

SECTION 12 T 18 N, R 7 W, TOWN OF FARMINGTON

LA CROSSE COUNTY

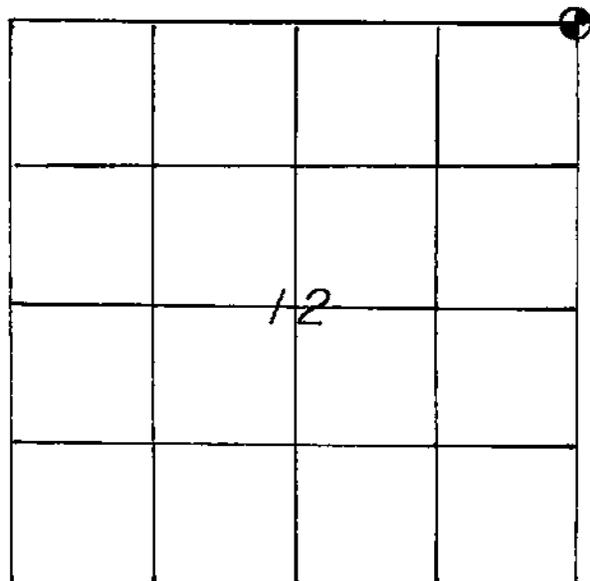

LOCATION OF LANDMARK

CREW: BILL JUNG, PERRY DAHL  
DATE: 2-13-87

## WISCONSIN COORDINATE SYSTEM

North

East

Theta Angle

Horiz. Order

Vert. Order

## TYPE OF LANDMARK

BERNTSEN TOP IN 2" IRON PIPE

BEARINGS ARE REFERENCED TO  
ASSUMED

Describe any record evidence, monument evidence, testimonial evidence or any other material evidence you considered and whether the monument was found or restored through acceptance of an obliterated evidence location.


Dick Berg set an iron pipe at the corner in 1981. I accepted this pipe location as the best available evidence of the original government corner position.

Describe or show any material discrepancy between the location of the restored corner and that of the corner previously restored or reestablished.

None known.

**RECORD OF DURABLE WITNESS MONUMENTS  
MAGNETIC**

NO	DESCRIPTION	BEARING	DISTANCE
1	P.K. NAIL IN DOUBLE-BLAZED 16" OAK	S71°W	18.6'
2	P.K. NAIL IN DOUBLE-BLAZED 6" CEDAR	S29°W	22.5'
3	P.K. NAIL IN DOUBLE-BLAZED 5" OAK	S52°E	7.03'
4	P.K. NAIL IN DOUBLE-BLAZED 4" OAK	N15°E	8.45'

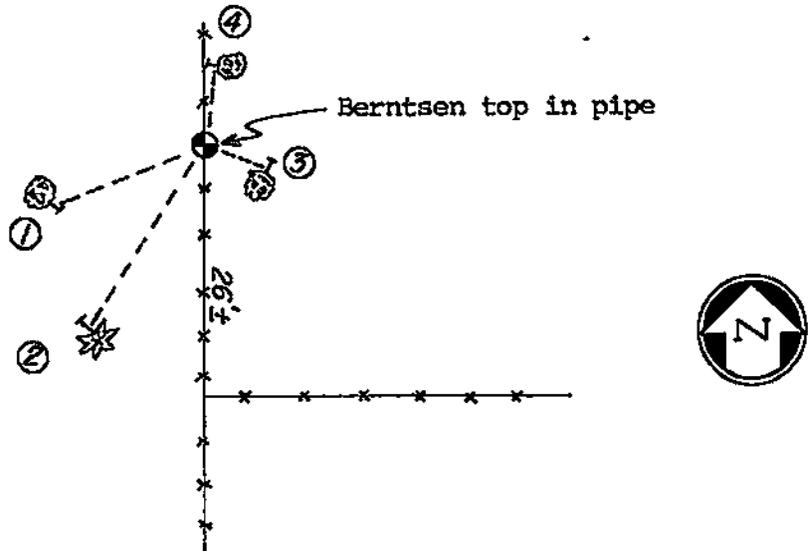


PLAN VIEW DRAWING OF REFERENCE TIES



MAP SHOWING DISTANCE AND DIRECTION TO OTHER PUBLIC LAND SURVEY CORNERS USED FOR REESTABLISHING THE CORNER


(not to scale)

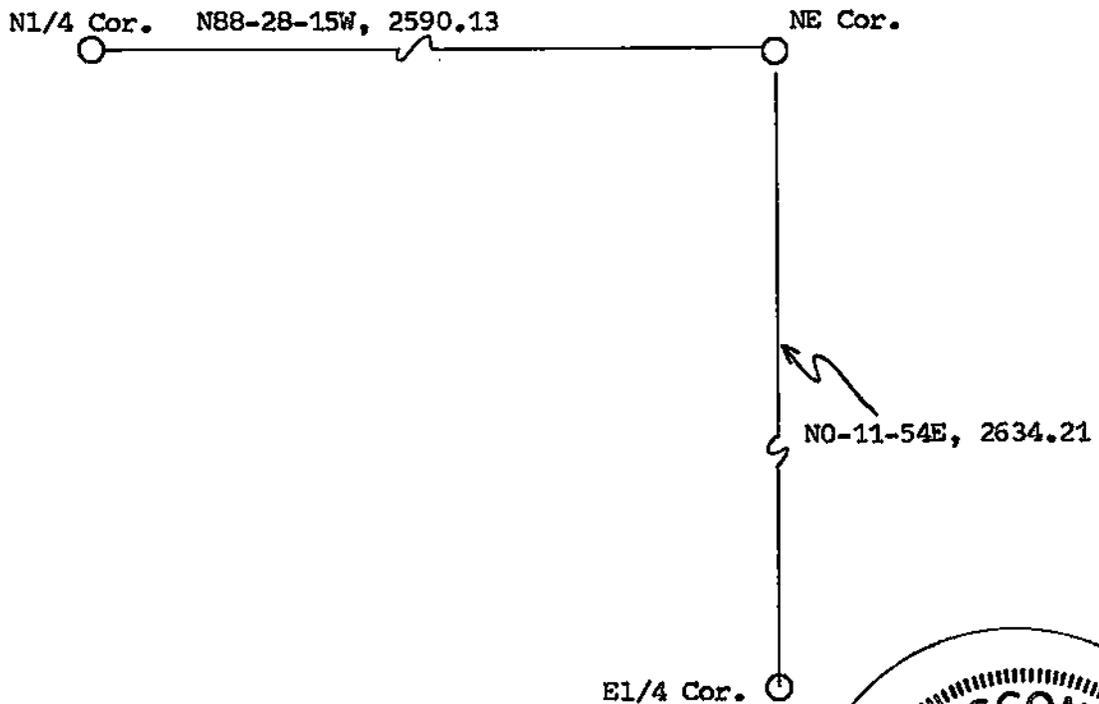

I, WILLIAM C. JUNG, DEPUTY COUNTY SURVEYOR,  
HEREBY CERTIFY THAT THE CORNER LOCATION SHOWN ON THIS RECORD  
WAS DETERMINED BY ME OR UNDER MY DIRECTION AND CONTROL AND  
THAT THIS U. S. PUBLIC LAND SURVEY MONUMENT RECORD IS CORRECT  
AND COMPLETE TO THE BEST OF MY KNOWLEDGE AND BELIEF.

*William C. Jung*  
Signature

March 4, 1987  
Date

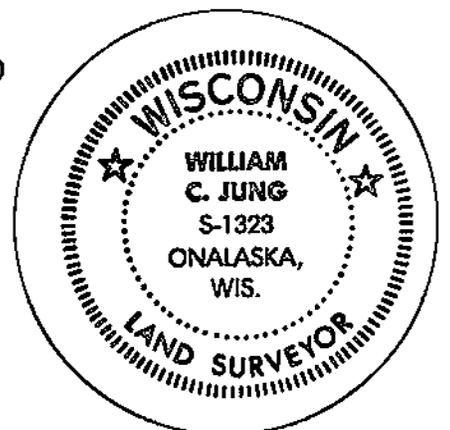

Seal