


## U. S. PUBLIC LAND SURVEY MONUMENT RECORD

SECTION 12 T 18 N, R 7 W, TOWN OF FARMINGTON

LA CROSSE COUNTY

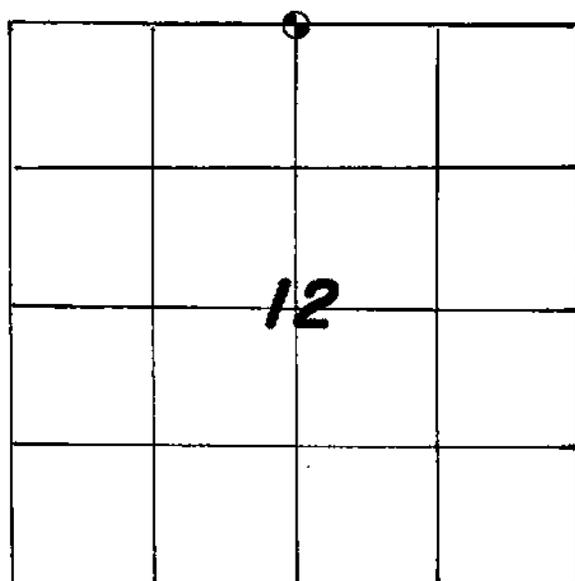

LOCATION OF LANDMARK

CREW: PERRY DAHL, BILL JUNG  
DATE: 3-5-87

WISCONSIN COORDINATE SYSTEM

North

East

Theta Angle

Horiz. Order

Vert. Order

TYPE OF LANDMARK

BRASS CAPPED LUNDE MARKER

BEARINGS ARE REFERENCED TO  
ASSUMED

Describe any record evidence, monument evidence, testimonial evidence or any other material evidence you considered and whether the monument was found or restored through acceptance of an obliterated evidence location.

I set the corner by single proportionate measurement, on line and equidistant between the section corners. I feel that the original surveyors "dropped" a chain when measuring this line.


Describe or show any material discrepancy between the location of the restored corner and that of the corner previously restored or reestablished.

None known.

RECORD OF DURABLE WITNESS MONUMENTS

ASSUMED


NO	DESCRIPTION	BEARING	DISTANCE
1	1" IRON PIPE ON WEST RIGHT-OF-WAY	N88°28'15"W	45.96'
2	P.K. NAIL IN POWER POLE	N86°53'E	14.48'
3	1" IRON PIPE ON EAST RIGHT-OF-WAY	S88°28'15"E	20.04'
4	P.K. NAIL IN CENTERLINE OF C.T.H. "V"	N88°28'15W	12.96'

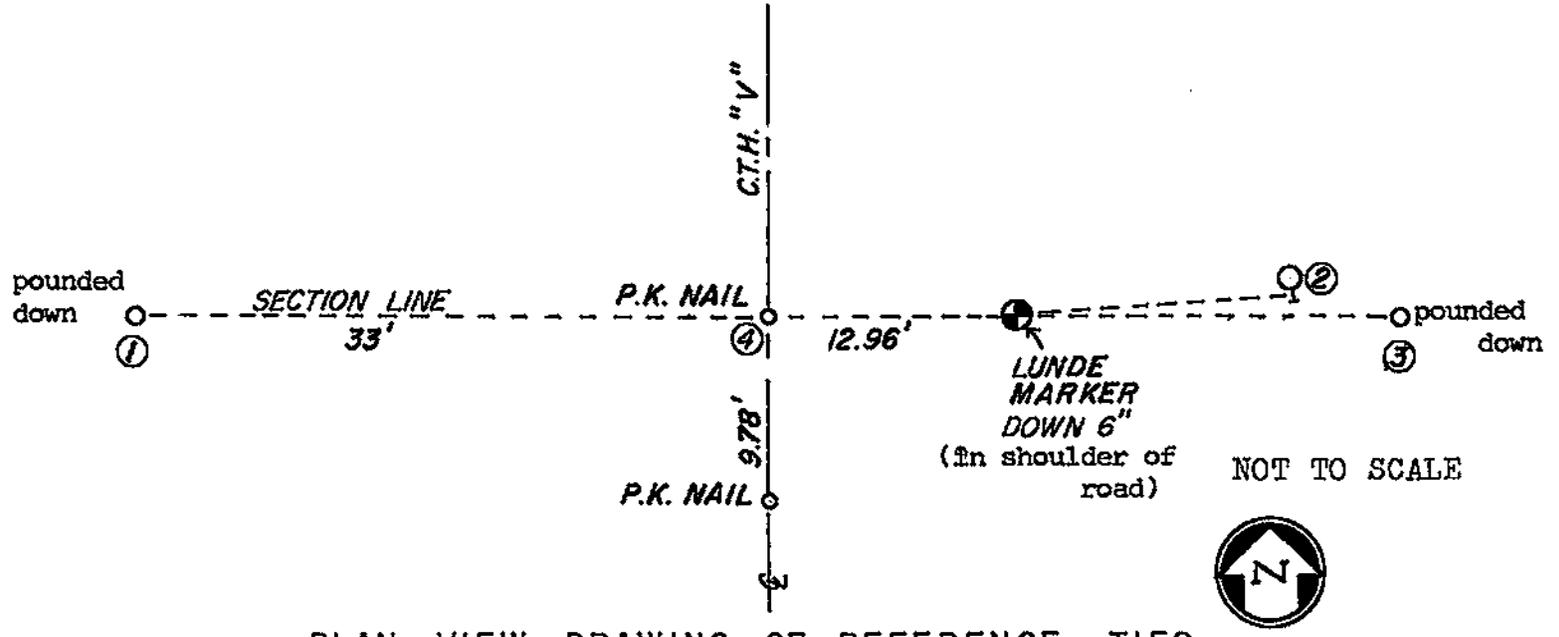

PLAN VIEW DRAWING OF REFERENCE TIES

MAP SHOWING DISTANCE AND DIRECTION TO OTHER PUBLIC LAND SURVEY CORNERS USED FOR REESTABLISHING THE CORNER


(not to scale)

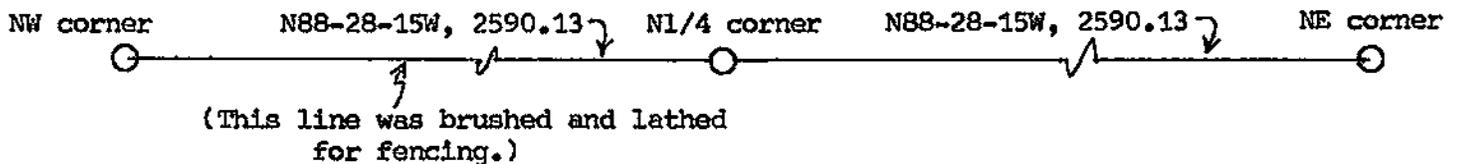

I, WILLIAM C. JUNG, DEPUTY COUNTY SURVEYOR  
 HEREBY CERTIFY THAT THE CORNER LOCATION SHOWN ON THIS RECORD  
 WAS DETERMINED BY ME OR UNDER MY DIRECTION AND CONTROL AND  
 THAT THIS U. S. PUBLIC LAND SURVEY MONUMENT RECORD IS CORRECT  
 AND COMPLETE TO THE BEST OF MY KNOWLEDGE AND BELIEF.

William C. Jung  
 Signature

March 12, 1987  
 Date

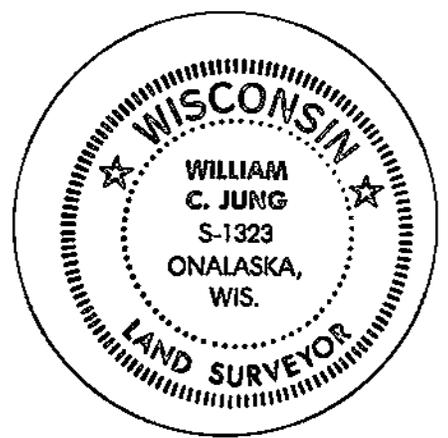

Seal