


U. S. PUBLIC LAND SURVEY MONUMENT RECORD

SECTION 1 T 18 N, R 7 W, TOWN OF FARMINGTON

LA CROSSE COUNTY

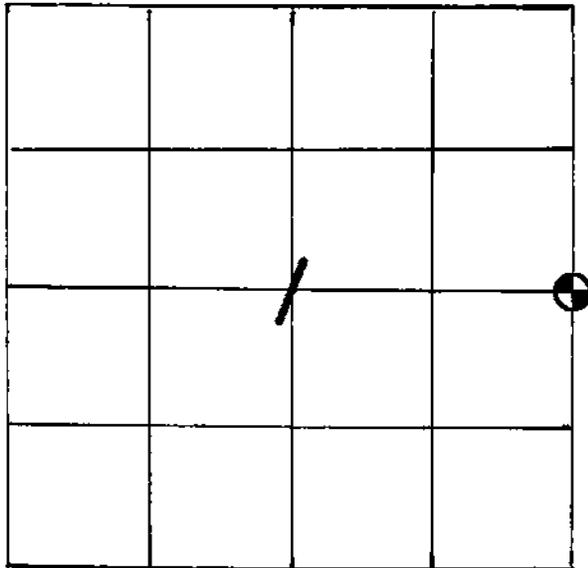

LOCATION OF LANDMARK

WISCONSIN COORDINATE SYSTEM

North

East

Theta Angle

Horiz. Order

Vert. Order

TYPE OF LANDMARK

Brass cap lande marker.

BEARINGS ARE REFERENCED TO

Crew: WILLIAM C. JUNG
 PETER F. FOLLANSBEE
 DATE: 12/20/1995

Describe any record evidence, monument evidence, testimonial evidence or any other material evidence you considered and whether the monument was found or restored through acceptance of an obliterated evidence location.

This corner was set at a computed location as determined by Norm Hurlburt in 1990. See Hurlburt's "Map of Survey", dated Jan. 3, 1991, for more detail.

Describe or show any material discrepancy between the location of the restored corner and that of the corner previously restored or reestablished.

None Known.

