


21807020000

## U. S. PUBLIC LAND SURVEY MONUMENT RECORD

SECTION 12 T 18 N, R 7 W, TOWN OF FARMINGTON

LA CROSSE COUNTY

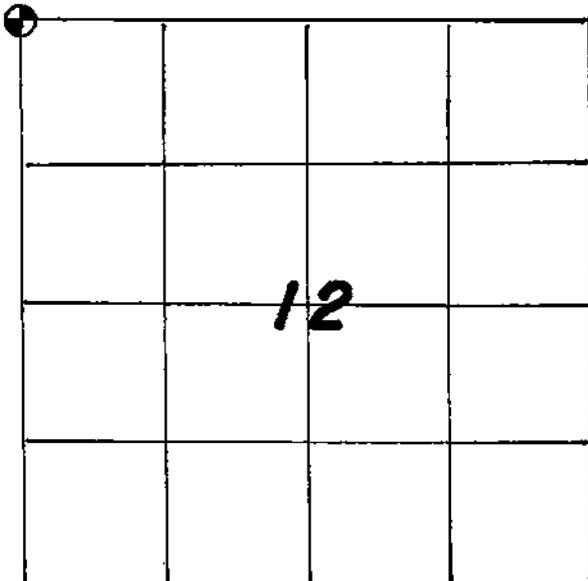

LOCATION OF LANDMARK

Crew: William C. Jung	Crew: William C. Jung
Perry L. Dahl	Peter Follansbee
3-3-87	3-20-07

## WISCONSIN COORDINATE SYSTEM

North

East

Theta Angle

Horiz. Order

Vert. Order

## TYPE OF LANDMARK

~~1 1/4" IRON PIPE~~ 30" Berntsen markerBEARINGS ARE REFERENCED TO  
ASSUMED

Describe any record evidence, monument evidence, testimonial evidence or any other material evidence you considered and whether the monument was found or restored through acceptance of an obliterated evidence location.

I found an iron pipe set by Ray Hengel at the occupied fence corner in 1983. I accepted this pipe as the best available evidence of the original government corner position.

3-20-07


The existing iron pipe was replaced with a Berntsen marker. New ties were taken. A sign was put on the fence post.

Describe or show any material discrepancy between the location of the restored corner and that of the corner previously restored or reestablished.

None known.


**RECORD OF DURABLE WITNESS MONUMENTS**  
MAGNETIC

NO	DESCRIPTION	BEARING	DISTANCE
1	P.K. NAIL IN DOUBLE-BLAZED 8" JACK PINE	<del>N34°W</del> N32°W	54.14'
2	P.K. NAIL IN DOUBLE-BLAZED 8" JACK PINE	<del>N78°W</del> N76°W	45.1'
3	<del>P.K. NAIL IN DOUBLE-BLAZED 28" WHITE OAK</del>	<del>S17°E</del>	<del>161.2'</del>
4	<del>P.K. NAIL IN DOUBLE-BLAZED 19" OAK TREE</del>	<del>S63°W</del>	<del>19.63'</del>

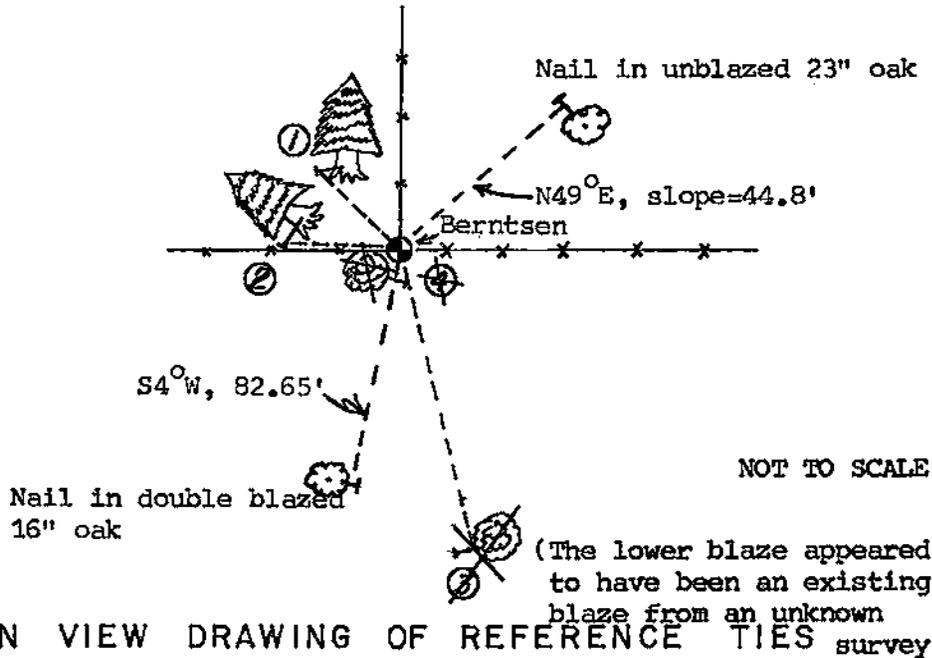

**MAP SHOWING DISTANCE AND DIRECTION TO OTHER PUBLIC LAND SURVEY CORNERS USED FOR REESTABLISHING THE CORNER**

(not to scale)

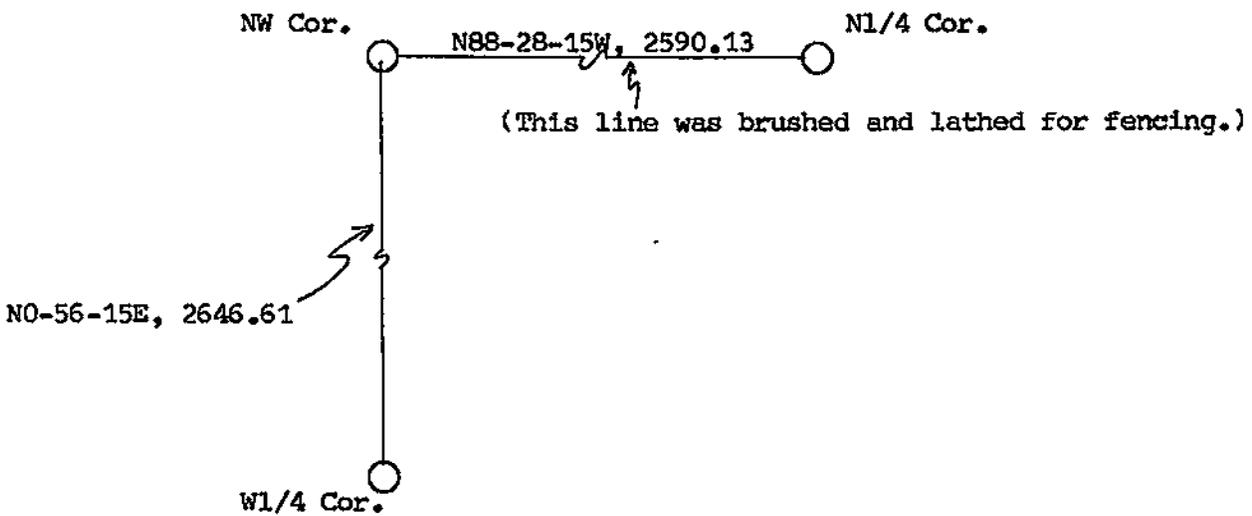

I, WILLIAM C. JUNG, DEPUTY COUNTY SURVEYOR  
HEREBY CERTIFY THAT THE CORNER LOCATION SHOWN ON THIS RECORD  
WAS DETERMINED BY ME OR UNDER MY DIRECTION AND CONTROL AND  
THAT THIS U. S. PUBLIC LAND SURVEY MONUMENT RECORD IS CORRECT  
AND COMPLETE TO THE BEST OF MY KNOWLEDGE AND BELIEF.

*William C. Jung*  
Signature

3-4-87  
Date  
Revised: 7-19-07 *weq*

