


U. S. PUBLIC LAND SURVEY MONUMENT RECORD

SECTION 2 T 18 N, R 7 W, TOWN OF Farmington

LA CROSSE COUNTY

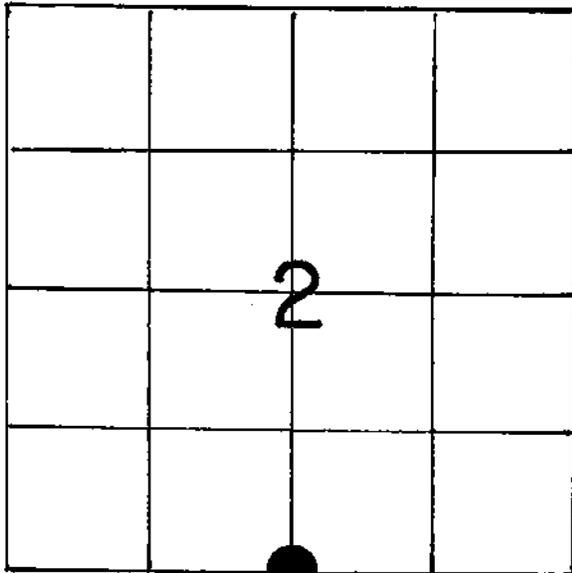

LOCATION OF LANDMARK

WISCONSIN COORDINATE SYSTEM

North

East

Theta Angle

Horiz. Order

Vert. Order

TYPE OF LANDMARK

Set brass cap Lunde marker

BEARINGS ARE REFERENCED TO

Crew: WILLIAM C. JUNG

Crew: William C. Jung

Date: 9/17/1991

Peter Follansbee

3/20/07

Describe any record evidence, monument evidence, testimonial evidence or any other material evidence you considered and whether the monument was found or restored through acceptance of an obliterated evidence location.

I accepted the iron pipe at the occupied corner as the best available evidence of the original government corner position. This pipe had been used as the corner in previous surveys. I replaced the pipe with a brass capped Lunde marker. A brandy bottle with a shell casing was buried on the SE side of the Lunde.

Describe or show any material discrepancy between the location of the restored corner and that of the corner previously restored or reestablished.

None known.

RECORD OF DURABLE WITNESS MONUMENTS
MAGNETIC

NO	DESCRIPTION	BEARING	DISTANCE
1	Set P.K. Nail in 18" to 2' Dia. Oak(NE-side)	N 87 W N 85°W	12.31 Ft.
2	Set P.K. Nail in NE-side 2' Burr Oak	N 24 W	42.99 Ft.
3	Set P.K. Nail in SE-side 13" White Oak	N 07 E N 11°E	8.32 Ft.
4	Set P.K. Nail in E-side 9" W. Oak w/sign	S 25 W	1.79 Ft.

w/sign

NOTE: ALL DISTANCES ARE TO SET P.K. NAILS IN SINGLE BLAZED TREES.

(dead)

NOTE: 34' NORTH OF THE LUNDE IS A 2' DIA. WHITE OAK. DISTANCE TO THE CENTER OF THE TREE. (unblazed)

1/4-COR., SEC. 2-18-7. SET BRASS CAP LUNDE MARKER AT FENCE INTERSECTION TO REPLACE AN EXISTING IRON PIPE, BURIED A BRANDY BOTTLE CONTAINING A SHELL CASING ON THE S.E.-SIDE.

NOT TO SCALE

PLAN VIEW DRAWING OF REFERENCE TIES

MAP SHOWING DISTANCE AND DIRECTION TO OTHER PUBLIC LAND SURVEY CORNERS USED FOR REESTABLISHING THE CORNER

No section measurements made by me at this time. See section data of record.

Notes:

N30°E, 18.40 feet to a nail on the northwest side of a double blazed 9" oak


S9°W, 15.04 feet to a nail on the northwest side of a 14" white oak with a skidder mark

I, William C. Jung, Deputy County Surveyor
HEREBY CERTIFY THAT THE CORNER LOCATION SHOWN ON THIS RECORD WAS DETERMINED BY ME OR UNDER MY DIRECTION AND CONTROL AND THAT THIS U. S. PUBLIC LAND SURVEY MONUMENT RECORD IS CORRECT AND COMPLETE TO THE BEST OF MY KNOWLEDGE AND BELIEF.

William C. Jung
Signature

November 8, 1991
Date

Revised: 7/19/07 *wcy*

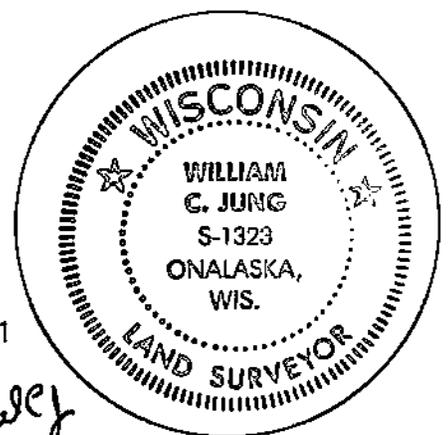

Seal