


21807022000

U. S. PUBLIC LAND SURVEY MONUMENT RECORD

SECTION 2 T 18 N, R 7 W, TOWN OF FARMINGTON

LA CROSSE COUNTY

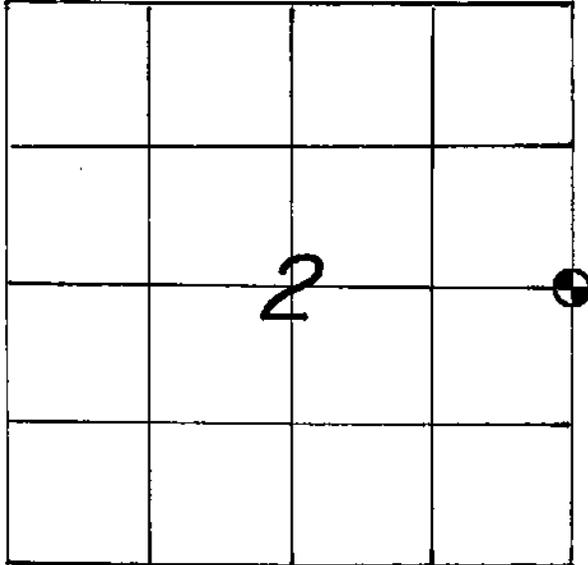

LOCATION OF LANDMARK

Crew: WILLIAM C. JUNG
 PETER F. FOLLANSBEE
 Date: 11/14/1995

WISCONSIN COORDINATE SYSTEM

North

East

Theta Angle

Horiz. Order

Vert. Order

TYPE OF LANDMARK

Brass cap lunde marker.

BEARINGS ARE REFERENCED TO

Describe any record evidence, monument evidence, testimonial evidence or any other material evidence you considered and whether the monument was found or restored through acceptance of an obliterated evidence location.


This corner was set at a computed location as determined by Norm Hurlburt in 1990. See Hurlburt's "Map of Survey", dated Jan. 3, 1991, for more detail.

Describe or show any material discrepancy between the location of the restored corner and that of the corner previously restored or reestablished.

None Known.

RECORD OF DURABLE WITNESS MONUMENTS

NO	DESCRIPTION	MAGNETIC	
		BEARING	DISTANCE
1	Set P.K. Nail in SE-side 4" White Pine	S 60° W	72.70 Ft.
2	Set P.K. Nail in SE-side 9½" Oak	S 72° W	29.55 Ft.
3	Set P.K. Nail in S.-side 4" White Pine	S 84° E	44.62 Ft.
4	Set P.K. Nail in E.-side 10" Oak	S 04° W	8.39 Ft.

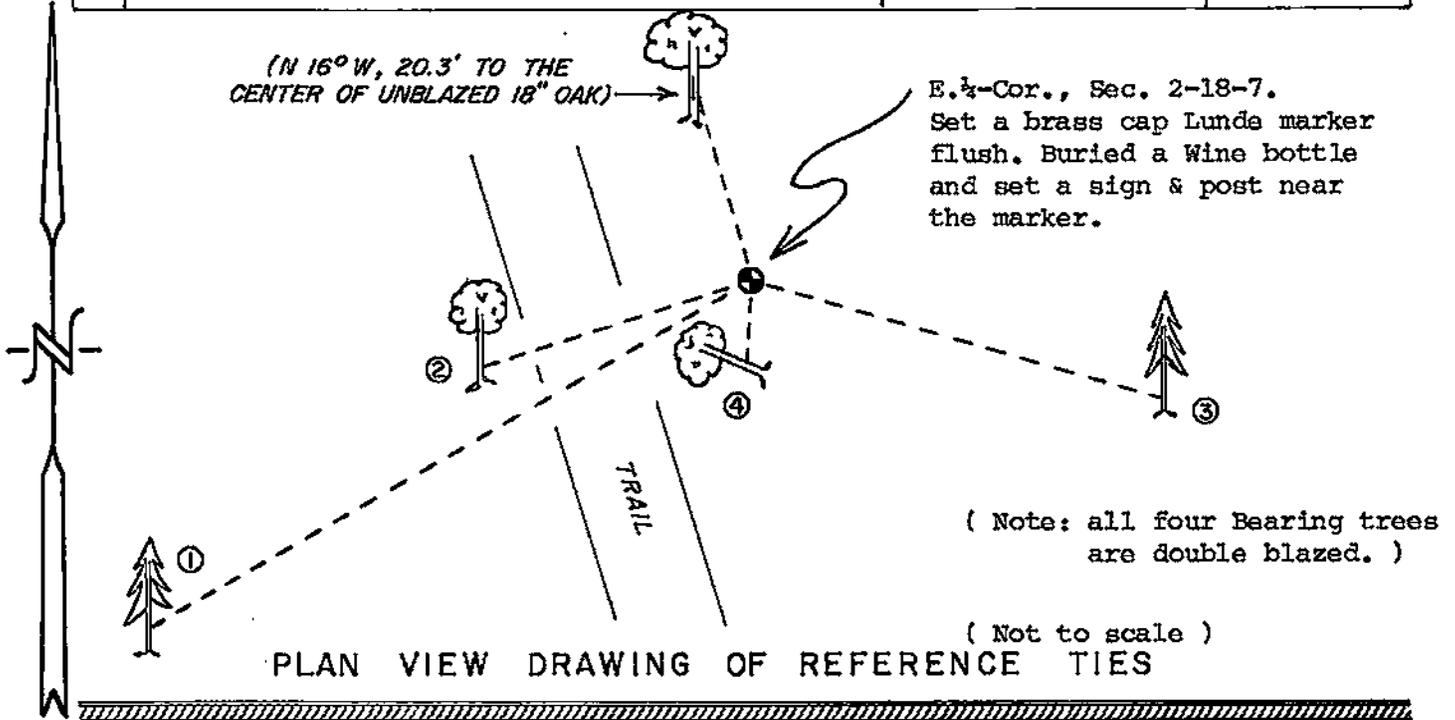

MAP SHOWING DISTANCE AND DIRECTION TO OTHER PUBLIC LAND SURVEY CORNERS USED FOR REESTABLISHING THE CORNER

No section measurements were made by me at this time. See section data of record.

I, William C. Jung, County Surveyor
HEREBY CERTIFY THAT THE CORNER LOCATION SHOWN ON THIS RECORD WAS DETERMINED BY ME OR UNDER MY DIRECTION AND CONTROL AND THAT THIS U. S. PUBLIC LAND SURVEY MONUMENT RECORD IS CORRECT AND COMPLETE TO THE BEST OF MY KNOWLEDGE AND BELIEF.

William C. Jung 12/29/95
Signature Date



Seal