


U. S. PUBLIC LAND SURVEY MONUMENT RECORD

SECTION 2 T 18 N, R 7 W, TOWN OF FARMINGTON  
 LA CROSSE COUNTY

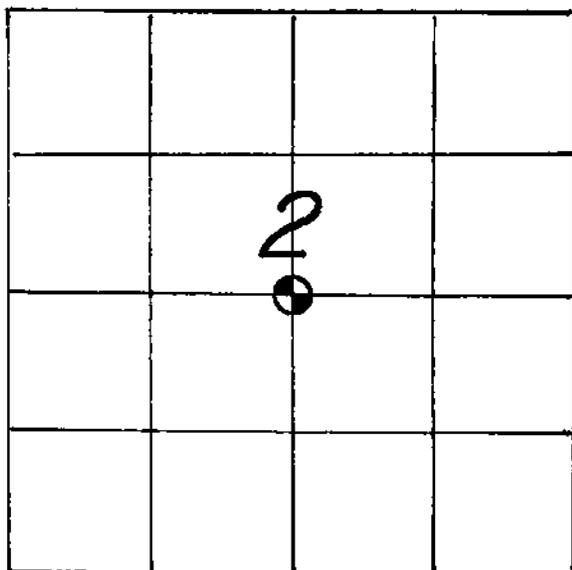

LOCATION OF LANDMARK

Crew: WILLIAM C. JUNG  
 PETER F. FOLLANSBEE  
 Date: 1/12/1996

WISCONSIN COORDINATE SYSTEM
North
East
Theta Angle
Horiz. Order
Vert. Order
TYPE OF LANDMARK
Existing Iron Pipe.
BEARINGS ARE REFERENCED TO

Describe any record evidence, monument evidence, testimonial evidence or any other material evidence you considered and whether the monument was found or restored through acceptance of an obliterated evidence location.


I found and tied off Hurlburt's corner of record. See Hurlburt's (2) "Maps of Survey", dated Jan. 3, 1991, for more detail.

Describe or show any material discrepancy between the location of the restored corner and that of the corner previously restored or reestablished.

None Known.

④, ②, and ③ are double blazed  
**RECORD OF DURABLE WITNESS MONUMENTS**

NO	DESCRIPTION	BEARING	DISTANCE
1	Ex. 3/4" Iron Pipe, (O.D.), driven flush.	Northeasterly $\pm$	21.90 Ft.
2	Set P.K. Nail in W.-side 8" Jack Pine	North $\pm$	15.83 Ft.
3	Set P.K. Nail in S.-side 17" Oak	West $\pm$	23.52 Ft.
4	Set P.K. Nail in NW-side 6" Oak	Southwesterly $\pm$	SL.=16.24'

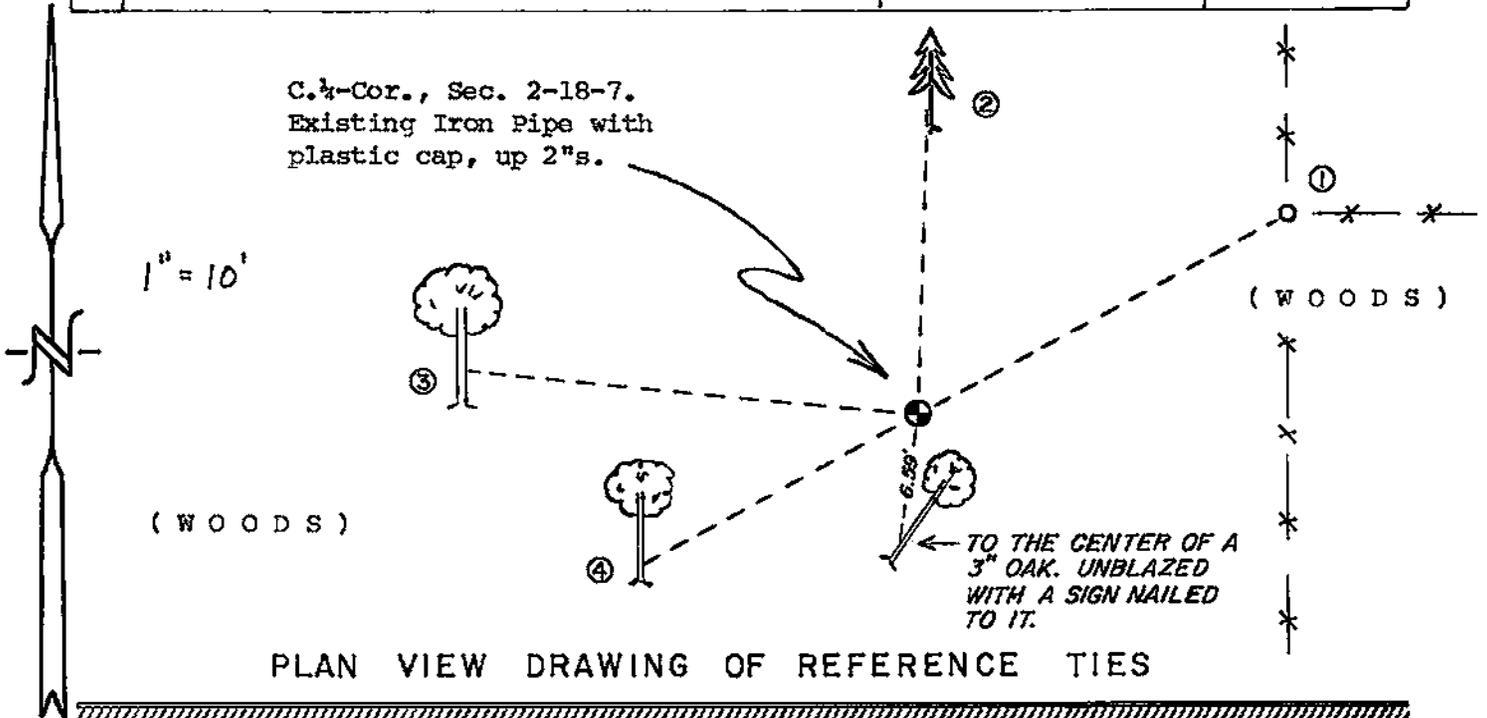


**MAP SHOWING DISTANCE AND DIRECTION TO OTHER PUBLIC LAND SURVEY CORNERS USED FOR REESTABLISHING THE CORNER**

No section measurements were made by me at this time. See section data of record.

I, William C. Jung, County Surveyor  
 HEREBY CERTIFY THAT THE CORNER LOCATION SHOWN ON THIS RECORD  
 WAS DETERMINED BY ME OR UNDER MY DIRECTION AND CONTROL AND  
 THAT THIS U. S. PUBLIC LAND SURVEY MONUMENT RECORD IS CORRECT  
 AND COMPLETE TO THE BEST OF MY KNOWLEDGE AND BELIEF.

William C. Jung 1/18/96  
 Signature Date

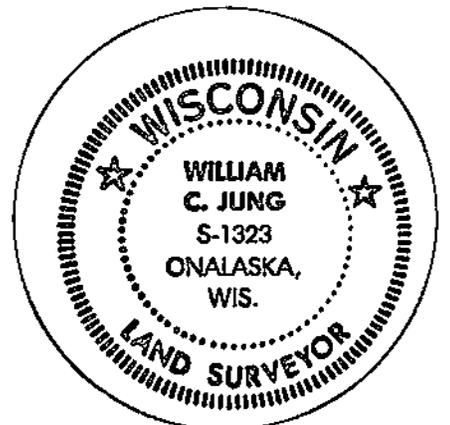

Seal