


21807030020

U. S. PUBLIC LAND SURVEY MONUMENT RECORD

SECTION 10 T 18 N, R 7 W, TOWN OF FARMINGTON

LA CROSSE COUNTY

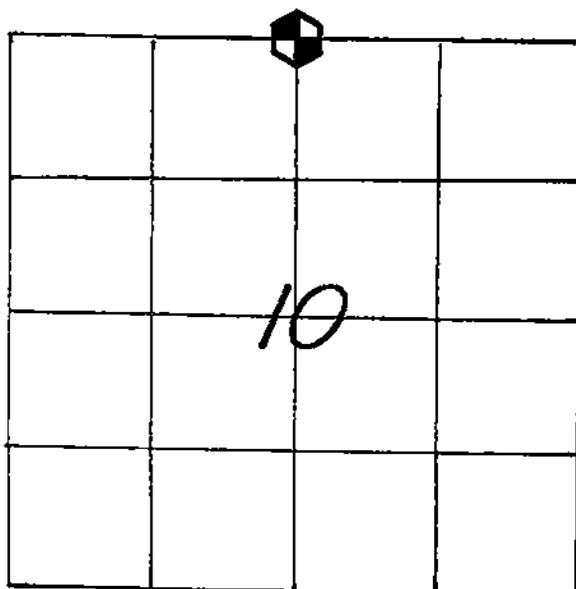

LOCATION OF LANDMARK

CREW: *WILLIAM C. JUNG*
PETER F. FOLLANSBEE
 DATE: *4/07/2004*

WISCONSIN COORDINATE SYSTEM

North

East

Theta Angle

Horiz. Order

Vert. Order

TYPE OF LANDMARK

BRASS CAP LUNDE MARKER.

BEARINGS ARE REFERENCED TO

Describe any record evidence, monument evidence, testimonial evidence or any other material evidence you considered and whether the monument was found or restored through acceptance of an obliterated evidence location.


There was an iron pipe of record at this corner that had been used in previous surveys. It was at the old occupied corner. We found this pipe knocked out and buried in the gravel of the driveway. We were able to determine the old pipe location. I accepted this location as the best available evidence of the original government corner position and monumented this location with a brass capped Lunde marker, down 6 inches or so.

Describe or show any material discrepancy between the location of the restored corner and that of the corner previously restored or reestablished.

On the road plan for the new bridge on Baker Road to the East, Evelyn Ferneding shows a nail at this location. I tied into the new road R/W and traversed to this corner. I found no nail and came out at a point 1.92 feet North of our final corner. We found an iron pipe 254.22 feet to the South. Our corner fits the record distance within 0.01 feet. I'm sure that we found the old pipe location.

RECORD OF DURABLE WITNESS MONUMENTS

NO	DESCRIPTION	MAGNETIC	
		BEARING	DISTANCE
1	SET A NAIL IN N.-SIDE OF A 23" OAK	WEST ±	18.79 FT.
2	SET A NAIL IN S.-SIDE OF A 9" WHITE OAK	EAST ±	11.86 FT.
3	SET A NAIL IN N.-SIDE OF AN 11" OAK	S 42° E	8.14 FT.
4	SET A NAIL IN E.-SIDE OF AN 18" OAK	S 06° E	7.20 FT.

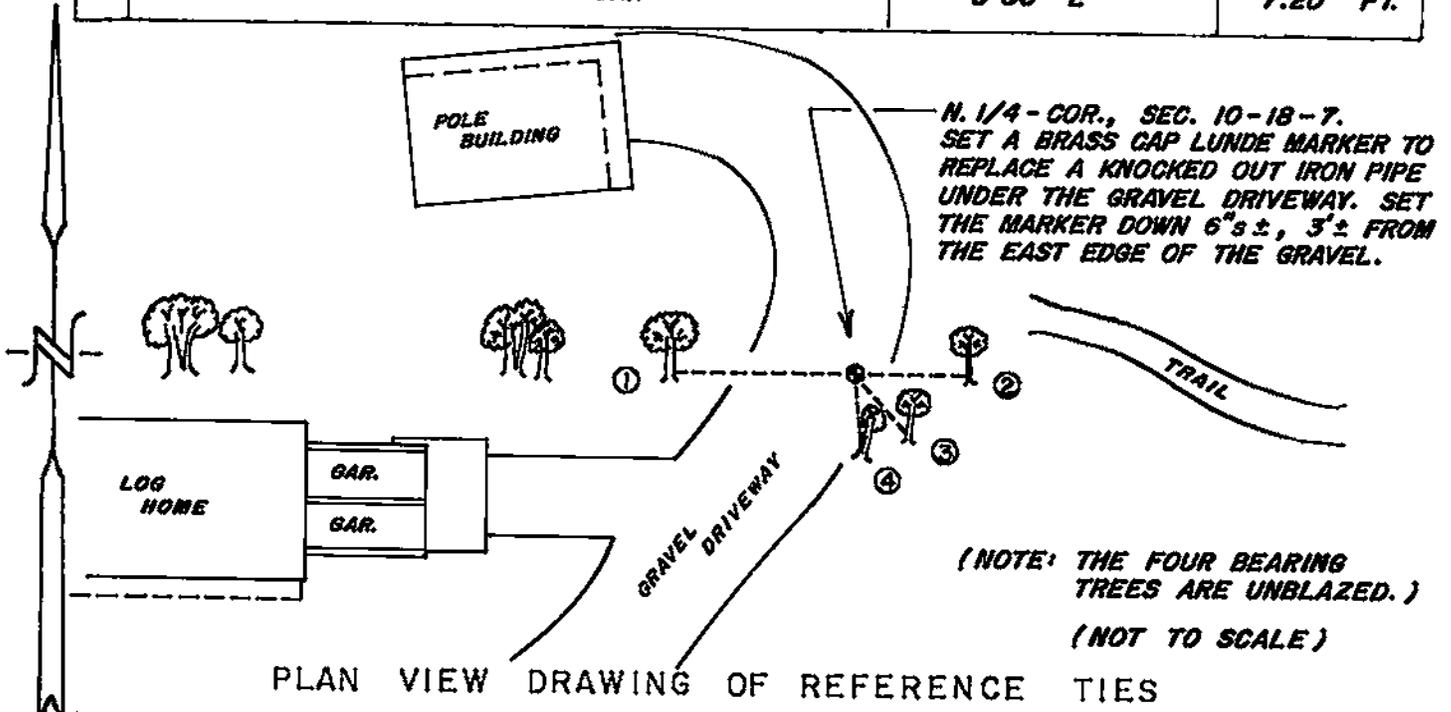


MAP SHOWING DISTANCE AND DIRECTION TO OTHER PUBLIC LAND SURVEY CORNERS USED FOR REESTABLISHING THE CORNER

I made no further section measurements at this time. I analyzed this corner based on surveys of record.

I, WILLIAM C. JUNG, COUNTY SURVEYOR
 HEREBY CERTIFY THAT THE CORNER LOCATION SHOWN ON THIS RECORD WAS DETERMINED BY ME OR UNDER MY DIRECTION AND CONTROL AND THAT THIS U. S. PUBLIC LAND SURVEY MONUMENT RECORD IS CORRECT AND COMPLETE TO THE BEST OF MY KNOWLEDGE AND BELIEF.

William C. Jung 1/7/05
 Signature Date

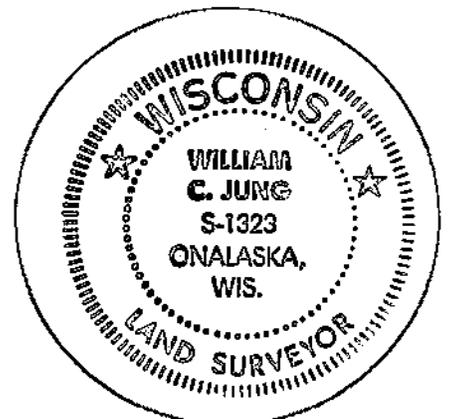

Seal