


21807040000

U. S. PUBLIC LAND SURVEY MONUMENT RECORD

SECTION 9 T 18 N, R 7 W, TOWN OF HOLLAND

LA CROSSE COUNTY

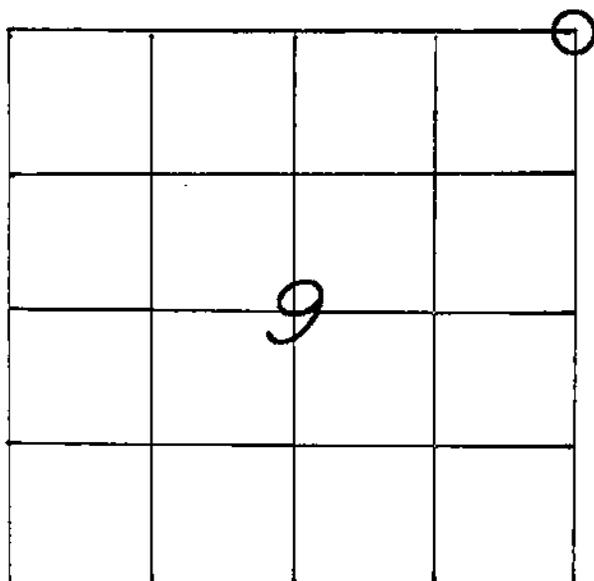

LOCATION OF LANDMARK

CREW: **WILLIAM C. JUNG**
PETER F. FOLLANSBEE
 DATE: **3/25/2002**

WISCONSIN COORDINATE SYSTEM

North **751,981.056**East **1,649,926.164**

Theta Angle

Horiz. Order

Vert. Order

DATUM: **1983('91)**

TYPE OF LANDMARK

1" IRON PIPE.

BEARINGS ARE REFERENCED TO
GRID NORTH AS PER SECTION DATA.

Describe any record evidence, monument evidence, testimonial evidence or any other material evidence you considered and whether the monument was found or restored through acceptance of an obliterated evidence location.

I found an iron pipe at the corner that had been used as the section corner in previous survey work. I accepted this pipe as the best available evidence of the original government corner position.


Describe or show any material discrepancy between the location of the restored corner and that of the corner previously restored or reestablished.

At first glance and after checking the surveys on file, this location may not fit the computed location as shown on 1983 maps from LaCrosse Engineering.

RECORD OF DURABLE WITNESS MONUMENTS


MAGNETIC

NO	DESCRIPTION	BEARING	DISTANCE
1	SET A NAIL IN S.E.-SIDE OF A 5" ASH	S 81° W	41.75 FT.
2	SET A NAIL IN N.E.-SIDE OF A 9-1/2" TRIPLE MAPLE	N 29° W	30.53 FT.
3	SET A NAIL IN N.W.-SIDE OF A 6-1/2" MAPLE w/sign	N 42° E	9.05 FT.
4	SET A NAIL IN N.-SIDE OF A 9" MAPLE	S 80° E	45.62 FT.

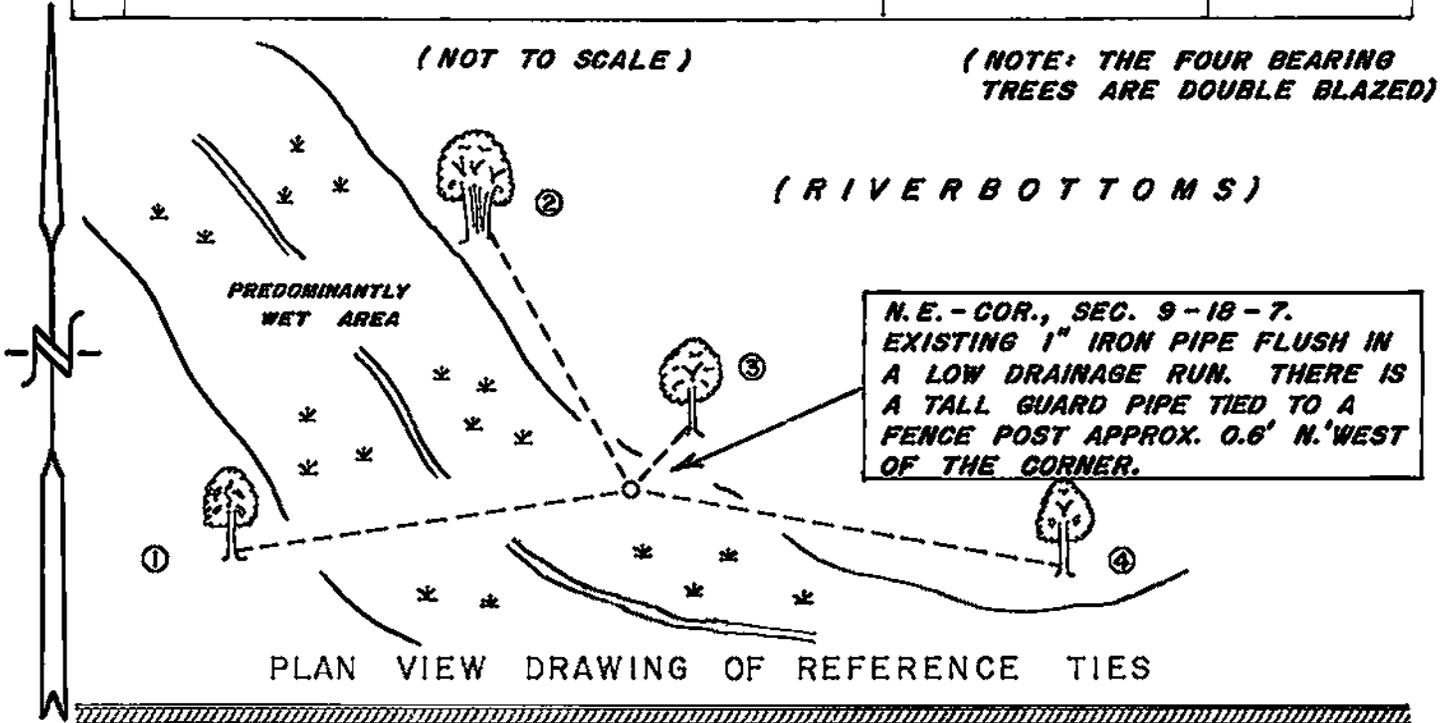

MAP SHOWING DISTANCE AND DIRECTION TO OTHER PUBLIC LAND SURVEY CORNERS USED FOR REESTABLISHING THE CORNER

(not to scale)

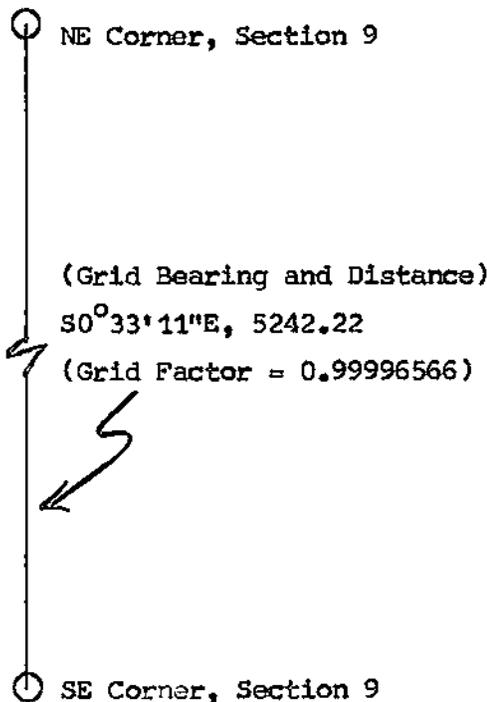

I, WILLIAM C. JUNG, COUNTY SURVEYOR
 HEREBY CERTIFY THAT THE CORNER LOCATION SHOWN ON THIS RECORD
 WAS DETERMINED BY ME OR UNDER MY DIRECTION AND CONTROL AND
 THAT THIS U. S. PUBLIC LAND SURVEY MONUMENT RECORD IS CORRECT
 AND COMPLETE TO THE BEST OF MY KNOWLEDGE AND BELIEF.

William C. Jung 4/24/02
 Signature Date



Seal