

2180705 2000

TREMPEALEAU COUNTY


U.S. PUBLIC LAND SURVEY MONUMENT RECORD

QUARTER Corner common to Sections 4 & 5

T. 18 N., R. 7 W.

Type of monument 7/8" X 30" REBAR WITH ALUMINUM CAP

Location indicated on sketch - ⊕ -

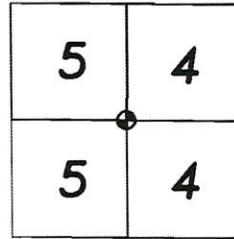


Location Sketch

Describe any record evidence, monument evidence, occupational evidence, testimonial evidence or any other material evidence you considered, and whether the monument was found or placed.

ORIGINAL GOVERNMENT ACCESSORIES WERE SEARCHED FOR, BUT NONE WERE FOUND. OTHER MONUMENT EVIDENCE WAS SEARCHED FOR, BUT NONE WAS FOUND. VARIOUS REMNANT FENCE LINES WERE FOUND, NONE OF WHICH OFFERED REASONABLE EVIDENCE AS TO THIS CORNER'S LOCATION. A POSITION FOR THIS CORNER WAS DETERMINED BY HOLDING SINGLE PROPORTIONATE MEASUREMENT BETWEEN THE NORTHEAST AND SOUTHEAST CORNERS OF SECTION 5-18-7. (THE SOUTHEAST CORNER OF SECTION 5-18-7 WAS RESTORED UNDER A JOINT EFFORT OF THE TREMPEALEAU COUNTY AND LACROSSE COUNTY SURVEYORS. THE TREMPEALEAU COUNTY SURVEYOR'S OFFICE SEARCHED THE POSITION FOR EXISTING CORNER EVIDENCE, WHILE THE LACROSSE COUNTY SURVEYOR'S OFFICE WILL MONUMENT THE CORNER LOCATION AT A LATER DATE.) THIS POSITION MATCHES ORIGINAL GOVERNMENT DISTANCE TO BOTH THE NORTHEAST AND SOUTHEAST CORNERS OF SECTION 5-18-7 BY ABOUT 8 FEET. IT ALSO MATCHES THE PROJECTION OF A REMNANT FENCE LINE FROM THE SOUTH, APPROXIMATELY 1360 FEET NORTH OF THIS POSITION, BY LESS THAN 3 FEET. THEREFORE, BELIEVING THIS POSITION, AS DESCRIBED, TO BE THE BEST AVAILABLE EVIDENCE OF THE LOCATION OF THE ORIGINAL GOVERNMENT CORNER, A MONUMENT WAS SET AND REFERENCED AS SHOWN BELOW.

Show a plan view drawing depicting the relevant monuments, providing reference ties to at least 4 witness monuments. Describe witness monuments. Show relationship to occupation.

- SET 5/8" X 24" REBAR WITH PLASTIC CAP

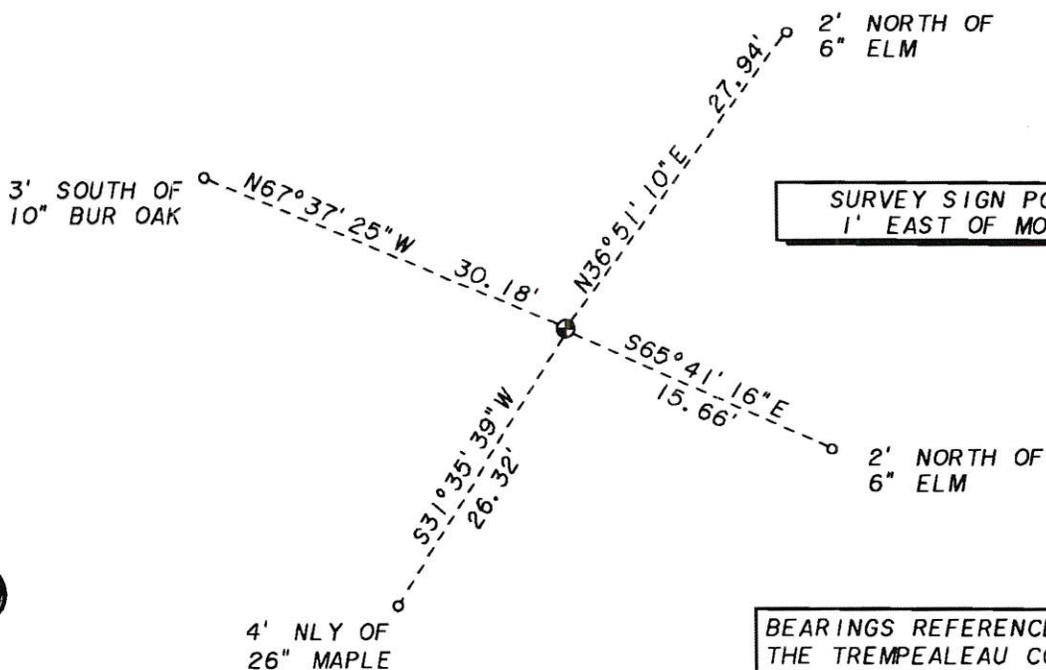

SURVEY SIGN POST
1' EAST OF MON.

BEARINGS REFERENCED TO
THE TREMPEALEAU COUNTY
COORDINATE SYSTEM

Corner identifier number

21807052000



no scale

Describe any material discrepancy between the location of the corner as restored or reestablished and the location of that corner as previously restored or reestablished by distance and direction. Show the discrepancy on the plan view drawing. Show the distances between the corner as restored or reestablished, and (1) the corner as restored or reestablished, and (2) to at least 2 of the witness monuments shown on the drawing.

NO MATERIAL DISCREPANCY WAS FOUND.

Was the corner restored through acceptance of (1) an obliterated evidence location, (2) a found perpetuated location, or (3) an existent corner location?

N/A.

Was the corner reestablished through lost corner proportionate methods? If so, show the method including the directions and distances to other public land survey corners used as evidence or used for proportioning in determining the corner location.

**YES. SINGLE PROPORTIONATE MEASUREMENT WAS USED BETWEEN THE NORTHEAST AND SOUTHEAST CORNERS OF SECTION 5-18-7.
NORTHEAST CORNER TO EAST QUARTER CORNER = $500^{\circ}02'43''$ W, 2559.21 FEET
EAST QUARTER CORNER TO SOUTHEAST CORNER = $500^{\circ}02'43''$ W, 2631.58 FEET
(BEARINGS REFERENCED TO THE TREMPLEAU COUNTY COORDINATE SYSTEM)**

Show the corner history of record in chronological order from Original Government Survey to present.

**ORIGINAL GOVERNMENT SURVEY - C. WOODWORTH - AUGUST 1847
SET QUARTER SECTION POST. MARKED TWO BEARING TREES.**

I, JOSEPH P. NELSEN
certify that the corner location shown on this record was determined by me or under my direction and control and that this U.S. Public Land Survey Monument Record is correct to the best of my knowledge and belief.

Joseph P. Nelsen 11-4-02
Signature Date

Affix Land Surveyor Seal

