


U. S. PUBLIC LAND SURVEY MONUMENT RECORD

SECTION 8 T 18 N, R 7 W, TOWN OF Holland

LA CROSSE COUNTY

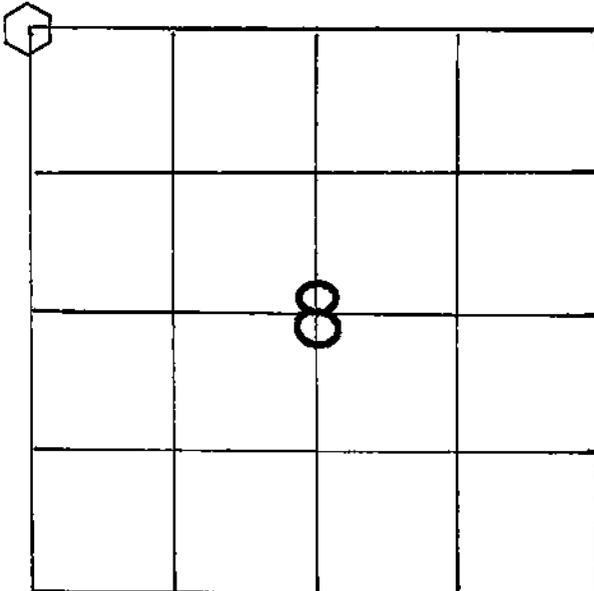

LOCATION OF LANDMARK

Crew: William C. Jung
Peter F. Follansbee

Date: March 22, 1994

Describe any record evidence, monument evidence, testimonial evidence or any other material evidence you considered and whether the monument was found or restored through acceptance of an obliterated evidence location.

I set this corner so as to best fit the occupied conditions by projecting East the old fence along the North line of the NE1/4-NE1/4 of Section 7 and projecting North the West line of the SW1/4-NW1/4 of Section 8. This location best fits the conditions and the original notes. I measured East too but saw no reason to go North across the river at this time. I set a brass capped Lunde marker at the corner, down 4".
Describe or show any material discrepancy between the location of the restored corner and that of the corner previously restored or reestablished.

None known.

WISCONSIN COORDINATE SYSTEM

North

East

Theta Angle

Horiz. Order

Vert. Order

TYPE OF LANDMARK


Brass capped Lunde marker

BEARINGS ARE REFERENCED TO

Assumed


RECORD OF DURABLE WITNESS MONUMENTS

NO	DESCRIPTION	MAGNETIC	
		BEARING	DISTANCE
1	Set P.K. Nail in N.-side 11½" Norway	N 85° W	49.72 Ft.
2	Set P.K. Nail in N.-side 12" Norway	N 85° E	79.91 Ft.
3	Set P.K. Nail in W.-side 6" Norway	S 07° E	24.65 Ft.
4	Set P.K. Nail in SE-side 5½" Norway	S 41° W	27.41 Ft.

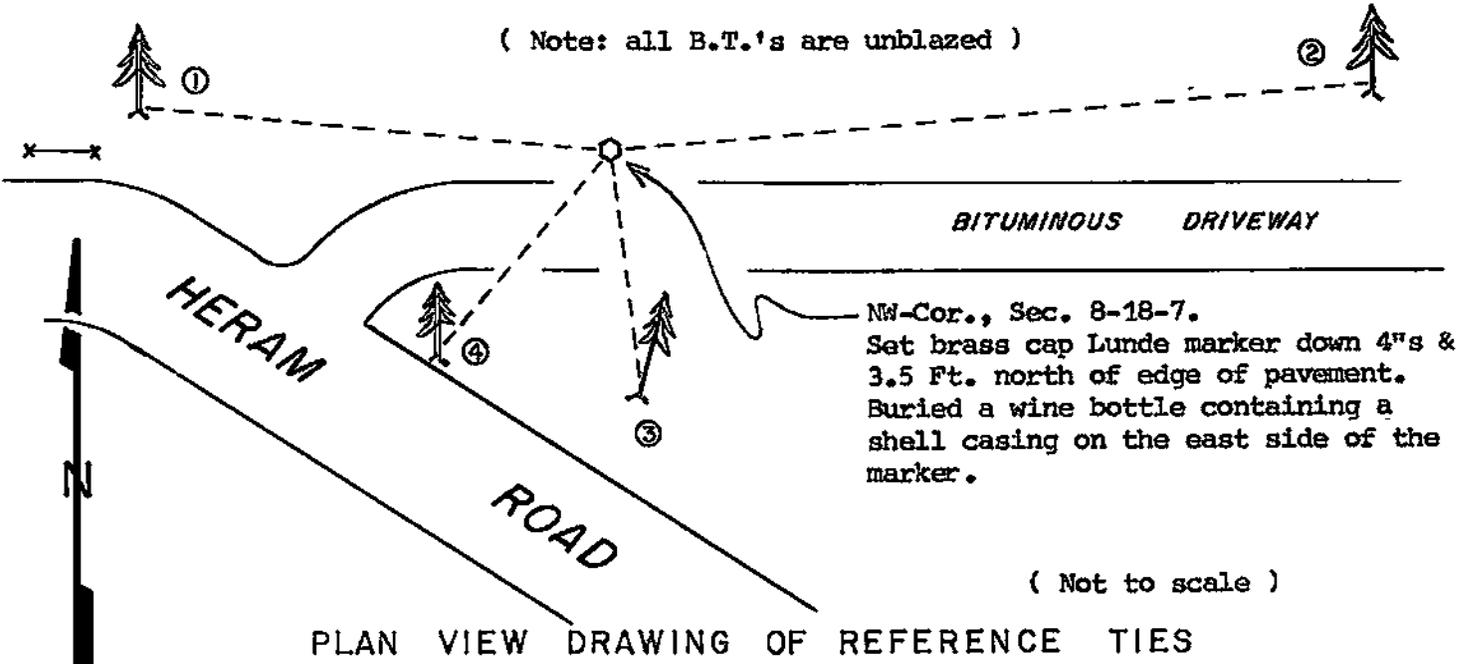

MAP SHOWING DISTANCE AND DIRECTION TO OTHER PUBLIC LAND SURVEY CORNERS USED FOR REESTABLISHING THE CORNER

(not to scale)

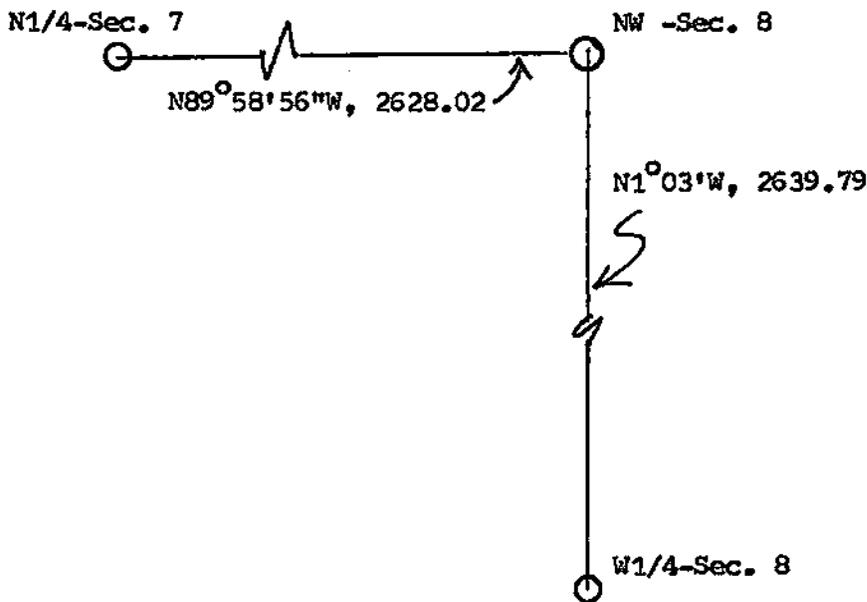

I, William C. Jung, County Surveyor,
HEREBY CERTIFY THAT THE CORNER LOCATION SHOWN ON THIS RECORD
WAS DETERMINED BY ME OR UNDER MY DIRECTION AND CONTROL AND
THAT THIS U. S. PUBLIC LAND SURVEY MONUMENT RECORD IS CORRECT
AND COMPLETE TO THE BEST OF MY KNOWLEDGE AND BELIEF.

William C. Jung April 26, 1994
Signature Date

