


21807060020

U. S. PUBLIC LAND SURVEY MONUMENT RECORD

SECTION 7 T 18 N, R 7 W, TOWN OF HOLLAND
 LA CROSSE COUNTY

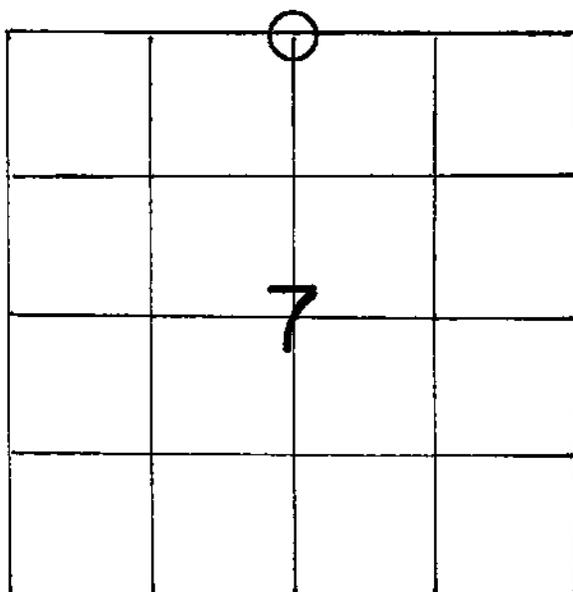

LOCATION OF LANDMARK

WISCONSIN COORDINATE SYSTEM

North

East

Theta Angle

Horiz. Order

Vert. Order

TYPE OF LANDMARK

Existing 2½" Iron Pipe (O.D.)

BEARINGS ARE REFERENCED TO

Assumed

Crew: WILLIAM C. JUNG
 PETER F. FOLLANSBEE

Date: 12/03/1993

Describe any record evidence, monument evidence, testimonial evidence or any other material evidence you considered and whether the monument was found or restored through acceptance of an obliterated evidence location.


I found an iron pipe at the old occupied corner. This pipe had been used as the corner in previous survey work. It fits the field conditions and evidence very well. I accepted it as the best available evidence of the original government survey position.

Describe or show any material discrepancy between the location of the restored corner and that of the corner previously restored or reestablished.

None Known.


RECORD OF DURABLE WITNESS MONUMENTS

NO	DESCRIPTION	BEARING	DISTANCE
1	Set P.K. Nail in W.-side 19" White Pine	Southerly \pm	46.79 Ft.
2	Set P.K. Nail in NE-side 7" Oak	Southeasterly \pm	5.54 Ft.
3	Set P.K. Nail in NE-side 6" Berry Tree(?)	Southeasterly \pm	6.73 Ft.
4	Set P.K. Nail in NE-side 10" Berry Tree(?)	Southeasterly \pm	10.98 Ft.

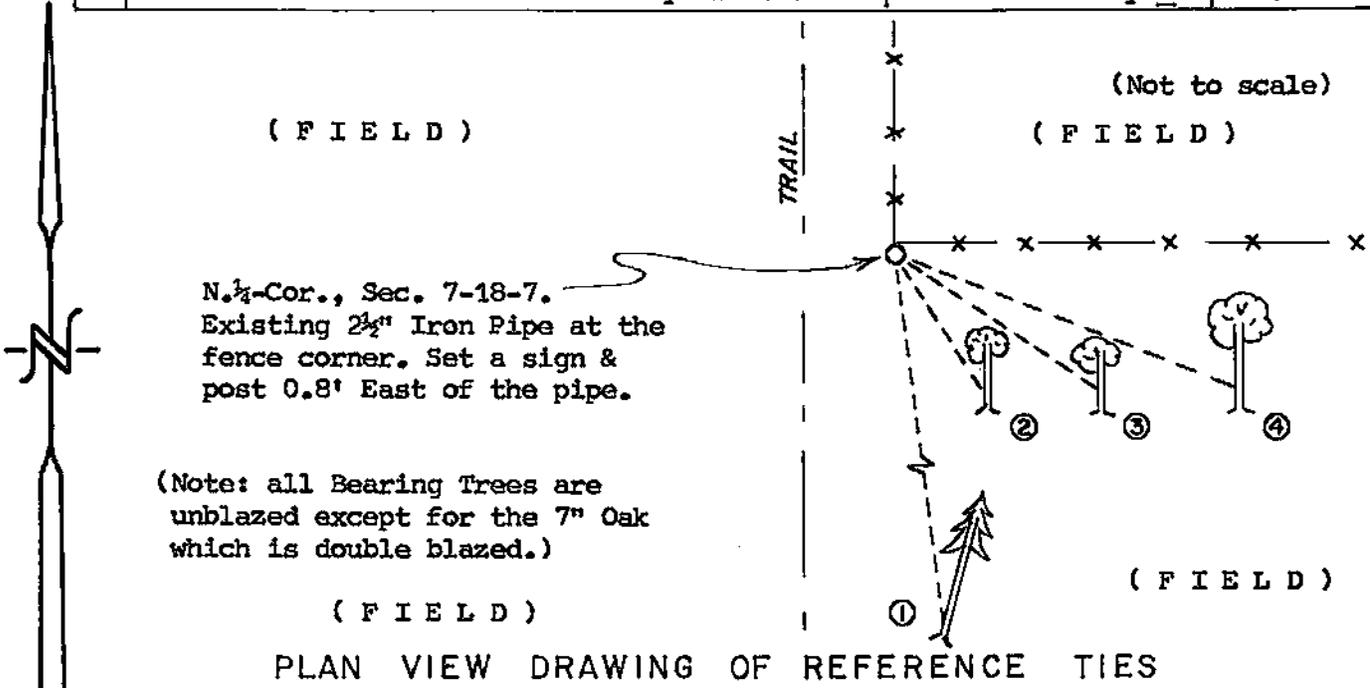

MAP SHOWING DISTANCE AND DIRECTION TO OTHER PUBLIC LAND SURVEY CORNERS USED FOR REESTABLISHING THE CORNER

(not to scale)

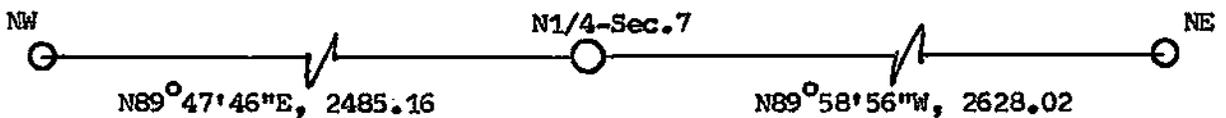

I, William C. Jung, County Surveyor
HEREBY CERTIFY THAT THE CORNER LOCATION SHOWN ON THIS RECORD WAS DETERMINED BY ME OR UNDER MY DIRECTION AND CONTROL AND THAT THIS U. S. PUBLIC LAND SURVEY MONUMENT RECORD IS CORRECT AND COMPLETE TO THE BEST OF MY KNOWLEDGE AND BELIEF.

William C. Jung April 26, 1994
Signature Date

