

21807062000

TREMPEALEAU COUNTY


U.S. PUBLIC LAND SURVEY MONUMENT RECORD

QUARTER Corner common to Sections 5 8 6

T. 18 N., R. 7 W.

Type of monument 7/8" X 30" REBAR WITH ALUMINUM CAP

Location indicated on sketch - ⊕ -

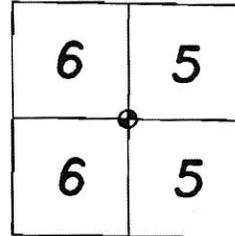


Location Sketch

Describe any record evidence, monument evidence, occupational evidence, testimonial evidence or any other material evidence you considered, and whether the monument was found or placed.

ORIGINAL GOVERNMENT ACCESSORIES WERE SEARCHED FOR, BUT NONE WERE FOUND. OTHER MONUMENT EVIDENCE WAS SEARCHED FOR, BUT NONE WAS FOUND. A POSITION FOR THIS CORNER WAS DETERMINED BY HOLDING SINGLE PROPORTIONATE MEASUREMENT BETWEEN THE NORTHEAST AND SOUTHEAST CORNERS OF SECTION 6-18-7. THIS POSITION MATCHES ORIGINAL GOVERNMENT DISTANCE TO BOTH THE NORTHEAST AND SOUTHEAST CORNERS OF SECTION 6-18-7 BY LESS THAN 1 FOOT. IT ALSO MATCHES OCCUPATION NEAR THE CENTER OF SECTION 6-18-7 BY ABOUT 1 FOOT, WHEN USING A PROPORTIONAL NORTH/SOUTH POSITION AT THE WEST QUARTER CORNER OF SECTION 6-18-7. THEREFORE, BELIEVING THIS POSITION, AS DESCRIBED, TO BE THE BEST AVAILABLE EVIDENCE OF THE LOCATION OF THE ORIGINAL GOVERNMENT CORNER, A MONUMENT WAS SET AND REFERENCED AS SHOWN BELOW.

Show a plan view drawing depicting the relevant monuments, providing reference ties to at least 4 witness monuments. Describe witness monuments. Show relationship to occupation.

○ SET 5/8" X 24" REBAR WITH PLASTIC CAP

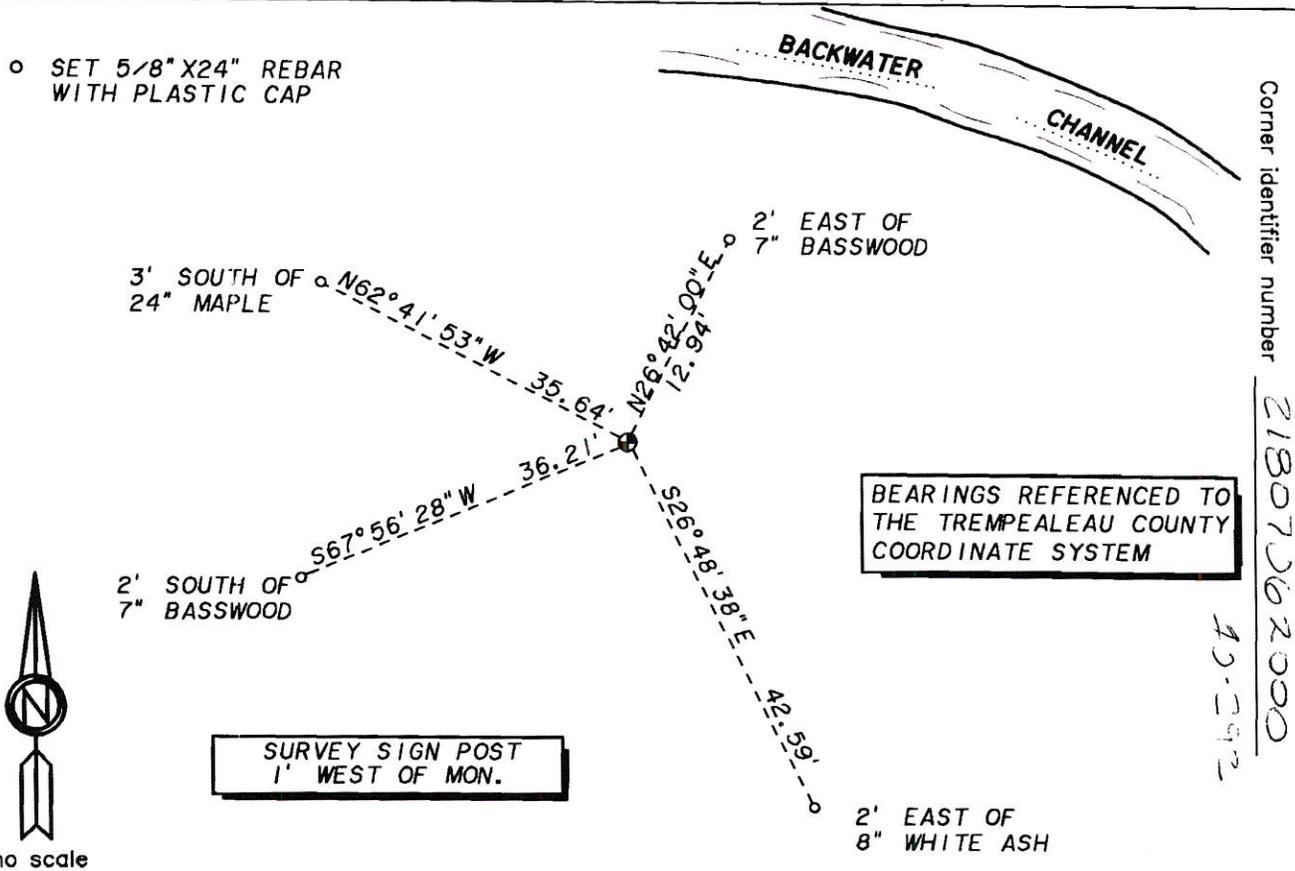

Describe any material discrepancy between the location of the corner as restored or reestablished and the location of that corner as previously restored or reestablished by distance and direction. Show the discrepancy on the plan view drawing. Show the distances between the corner as restored or reestablished, and (1) the corner as restored or reestablished, and (2) to at least 2 of the witness monuments shown on the drawing.

NO MATERIAL DISCREPANCY WAS FOUND.

Was the corner restored through acceptance of (1) an obliterated evidence location, (2) a found perpetuated location, or (3) an existent corner location?

N/A.

Was the corner reestablished through lost corner proportionate methods? If so, show the method including the directions and distances to other public land survey corners used as evidence or used for proportioning in determining the corner location.

**YES. SINGLE PROPORTIONATE MEASUREMENT WAS USED BETWEEN THE NORTHEAST AND SOUTHEAST CORNERS OF SECTION 6-18-7.
NORTHEAST CORNER TO EAST QUARTER CORNER - $500^{\circ}30'51''E$, 2534.92 FEET
EAST QUARTER CORNER TO SOUTHEAST CORNER - $500^{\circ}30'51''E$, 2639.17 FEET
(BEARINGS REFERENCED TO THE TREMPLEAU COUNTY COORDINATE SYSTEM)**

Show the corner history of record in chronological order from Original Government Survey to present.

**ORIGINAL GOVERNMENT SURVEY - C. WOODWORTH - AUGUST 1847
SET QUARTER SECTION POST. MARKED TWO BEARING TREES.**

I, JOSEPH P. NELSEN
certify that the corner location shown on this record was determined by me or under my direction and control and that this U.S. Public Land Survey Monument Record is correct to the best of my knowledge and belief.

Joseph P. Nelsen
Signature

11-4-02
Date

Affix Land Surveyor Seal

