


21807070000

## U. S. PUBLIC LAND SURVEY MONUMENT RECORD

SECTION 7 T 18 N, R 7 W, TOWN OF Holland

LA CROSSE COUNTY

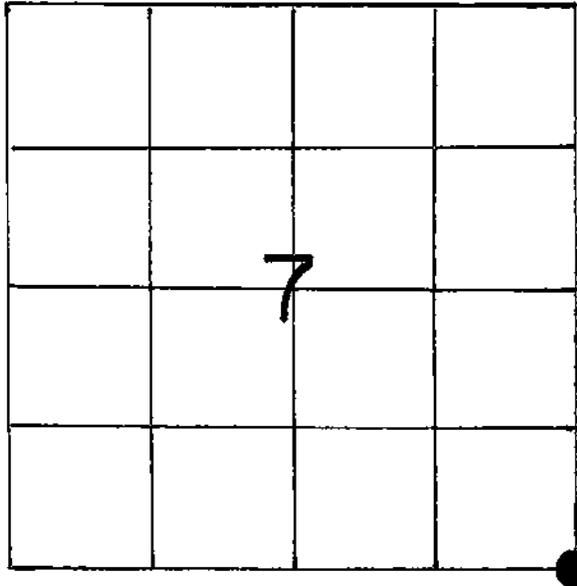

LOCATION OF LANDMARK

Crew: William C. Jung  
Peter F. Follansbee

Date: July 9, 1992

Describe any record evidence, monument evidence, testimonial evidence or any other material evidence you considered and whether the monument was found or restored through acceptance of an obliterated evidence location.

The old occupied corner has been used as the corner in previous survey work. I found an old rotted hub here in October of 1985 and replaced it with a 1½" iron pipe. I accepted this location as the best available evidence of the original government corner position. The pipe is North of the post. In July of 1992 I set a Berntsen top in the iron pipe. A sign and post were set by the marker.

Describe or show any material discrepancy between the location of the restored corner and that of the corner previously restored or reestablished.

None known.

## WISCONSIN COORDINATE SYSTEM

North

East

Theta Angle

Horiz. Order

Vert. Order

## TYPE OF LANDMARK


Berntsen top in an existing iron pipe

## BEARINGS ARE REFERENCED TO

Assumed

RECORD OF DURABLE WITNESS MONUMENTS

NO	DESCRIPTION	BEARING	DISTANCE
1	Set 1 1/4" iron pipe	North	6'
2	"	East	6'
3	"	South	6'
4	"	West	6'

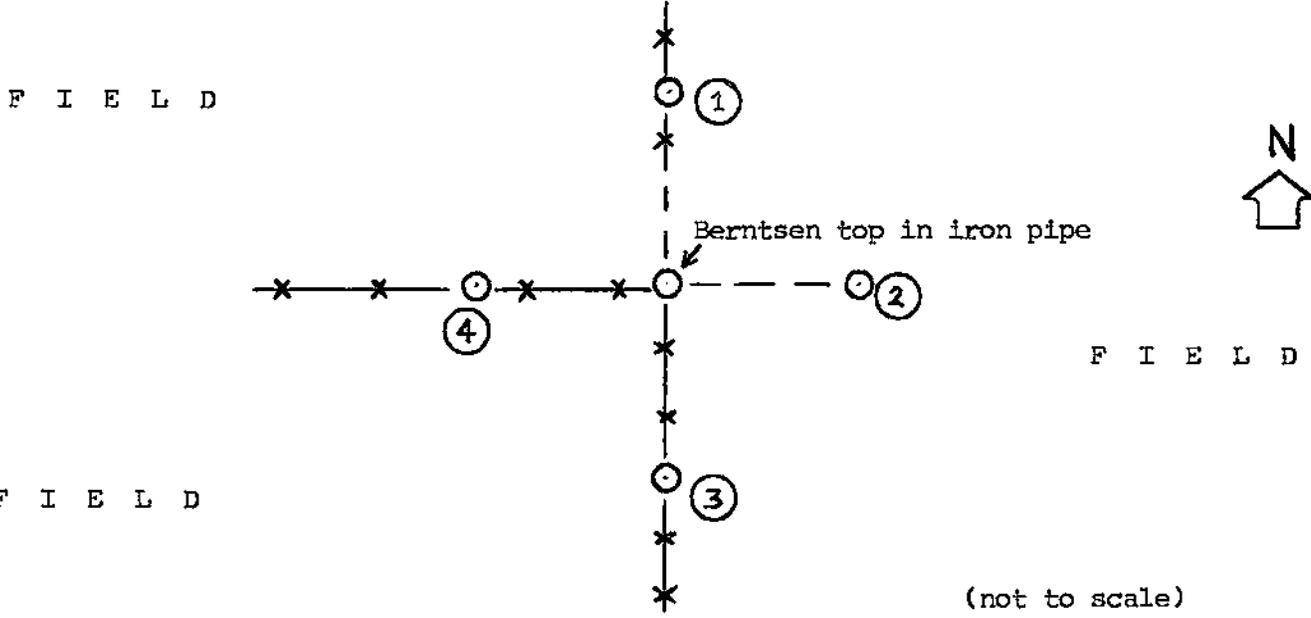


PLAN VIEW DRAWING OF REFERENCE TIES




MAP SHOWING DISTANCE AND DIRECTION TO OTHER PUBLIC LAND SURVEY CORNERS USED FOR REESTABLISHING THE CORNER

(not to scale)

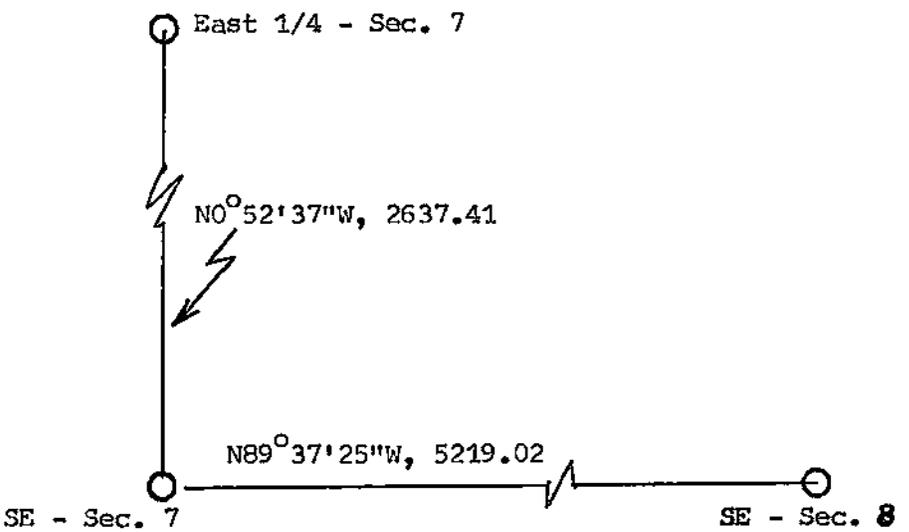

I, William C. Jung, Deputy County Surveyor,  
 HEREBY CERTIFY THAT THE CORNER LOCATION SHOWN ON THIS RECORD  
 WAS DETERMINED BY ME OR UNDER MY DIRECTION AND CONTROL AND  
 THAT THIS U. S. PUBLIC LAND SURVEY MONUMENT RECORD IS CORRECT  
 AND COMPLETE TO THE BEST OF MY KNOWLEDGE AND BELIEF.

William C. Jung July 20, 1992  
 Signature Date

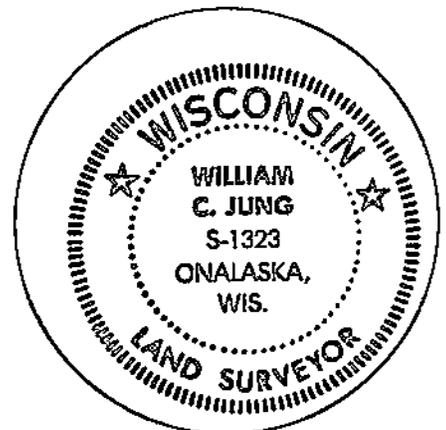

Seal