


21807070020

U. S. PUBLIC LAND SURVEY MONUMENT RECORD

SECTION 7 T 18 N, R 7 W, TOWN OF HOLLAND

LA CROSSE COUNTY

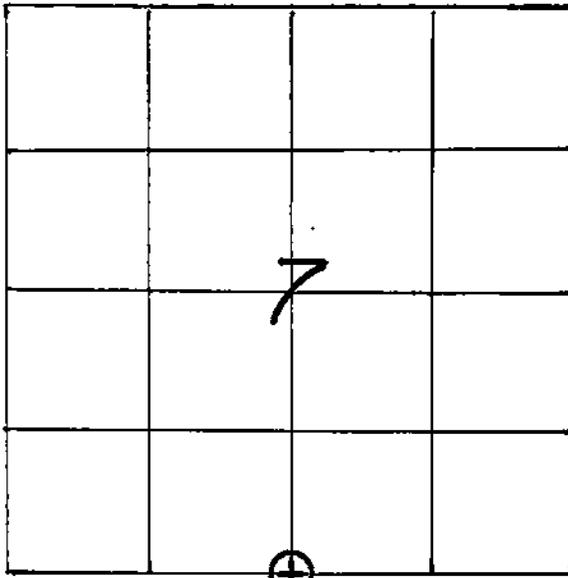

LOCATION OF LANDMARK

CREW: WILLIAM C. JUNG
 PETER F. FOLLANSBEE
 DATE: 4/12/2002

WISCONSIN COORDINATE SYSTEM

North

East

Theta Angle

Horiz. Order

Vert. Order

TYPE OF LANDMARK

3/4" x 30" IRON BAR WITH ALUMINUM CAP.

BEARINGS ARE REFERENCED TO

Describe any record evidence, monument evidence, testimonial evidence or any other material evidence you considered and whether the monument was found or restored through acceptance of an obliterated evidence location.


Mike Harding and I searched the area of this corner at length looking for old evidence. We found an old rotted tie post, down, with a lot of North-South tie wire on it. This location fits the computed location that we had agreed on. The corner was monumented with an iron bar and cap. I believe that the old post was the best evidence of the original government corner position.

Describe or show any material discrepancy between the location of the restored corner and that of the corner previously restored or reestablished.

Steve Solberg had two previously computed locations for this corner in 1994 and 1996, neither of which agreed with each other. Harding and I do not agree with either one of them.

RECORD OF DURABLE WITNESS MONUMENTS
MAGNETIC

NO	DESCRIPTION	BEARING	DISTANCE
1	SET A NAIL IN S.W.-SIDE OF A 10" WHITE OAK	N 50° W	SLOPE= 42.15'
2	SET A NAIL IN N.-SIDE OF AN 11-1/2" ASH	S 86° W	26.02 FT.
3	SET A NAIL IN N.W.-SIDE OF A 22" WHITE OAK	S 11° W	32.61 FT.
4	SET A NAIL IN S.W.-SIDE OF A 16" OAK	S 50° E	35.11 FT.

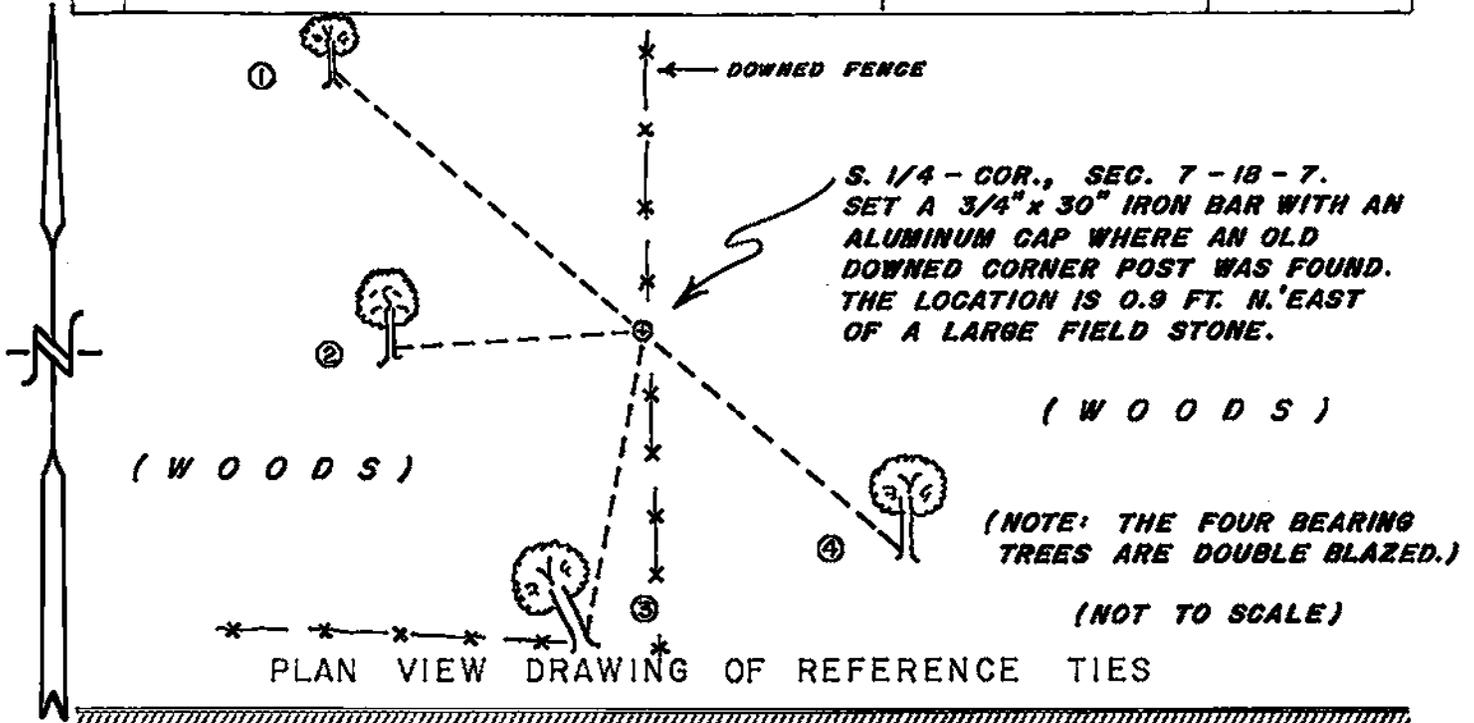

MAP SHOWING DISTANCE AND DIRECTION TO OTHER PUBLIC LAND SURVEY CORNERS USED FOR REESTABLISHING THE CORNER

The location of this corner was confirmed with Harding's section measurements.

I, WILLIAM C. JUNG, COUNTY SURVEYOR
HEREBY CERTIFY THAT THE CORNER LOCATION SHOWN ON THIS RECORD WAS DETERMINED BY ME OR UNDER MY DIRECTION AND CONTROL AND THAT THIS U. S. PUBLIC LAND SURVEY MONUMENT RECORD IS CORRECT AND COMPLETE TO THE BEST OF MY KNOWLEDGE AND BELIEF.

William C. Jung 4/19/02
Signature Date



Seal