


21807072000

## U. S. PUBLIC LAND SURVEY MONUMENT RECORD

SECTION 8 T 18 N, R 7 W, TOWN OF HOLLAND

LA CROSSE COUNTY

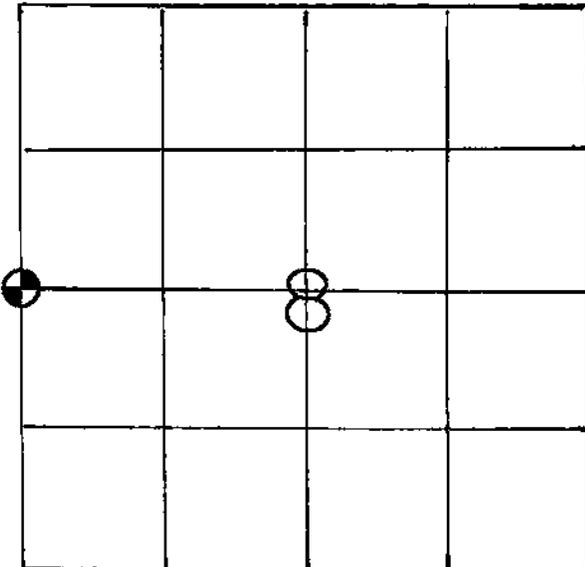

LOCATION OF LANDMARK

## WISCONSIN COORDINATE SYSTEM

North

East

Theta Angle

Horiz. Order

Vert. Order

## TYPE OF LANDMARK

~~RAILROAD SPIKE~~ P.K. nail and cap

## BEARINGS ARE REFERENCED TO

Assumed

CREW: BILL JUNG  
PERRY DAHL  
DATE: 10-21-85Crew: William C. Jung  
Peter F. Follansbee  
Date: 10-17-05

Describe any record evidence, monument evidence, testimonial evidence or any other material evidence you considered and whether the monument was found or restored through acceptance of an obliterated evidence location.

The old 1939 County Highway Plan shows the road to be on the 1/4 line. I found a P.K. nail in the centerline of the road and on line with an old line fence to the South. This P.K. nail also lines up with the property line to the North. The distance South to the section corner fits the original government distance very well. I accepted the occupied corner as the best available evidence of the original government corner and replaced the P.K. nail with a railroad spike. \*\*\*\*\*

Describe or show any material discrepancy between the location of the restored corner and that of the corner previously restored or reestablished.


None known.

\*\*\*\*\* 2005 -The railroad spike was knocked out due to road repaving.  
We set a P.K. nail and cap at the corner.

RECORD OF DURABLE WITNESS MONUMENTS

NO	DESCRIPTION	BEARING	DISTANCE
1	Set a 34" P.K. NAIL IN UNBLAZED 24" OAK TREE	N05°W $\pm$	33.00'
2	Set a 27" P.K. NAIL IN UNBLAZED 21" BURR OAK	N60°W $\pm$	65.31'
3	1½" IRON PIPE ( <del>Set</del> ) (existing)	SOUTH+	24.75'
4	1½" IRON PIPE (Set at Southwest Sec. Cor.)	N00°52'37"W	2637.41'

(Assumed)

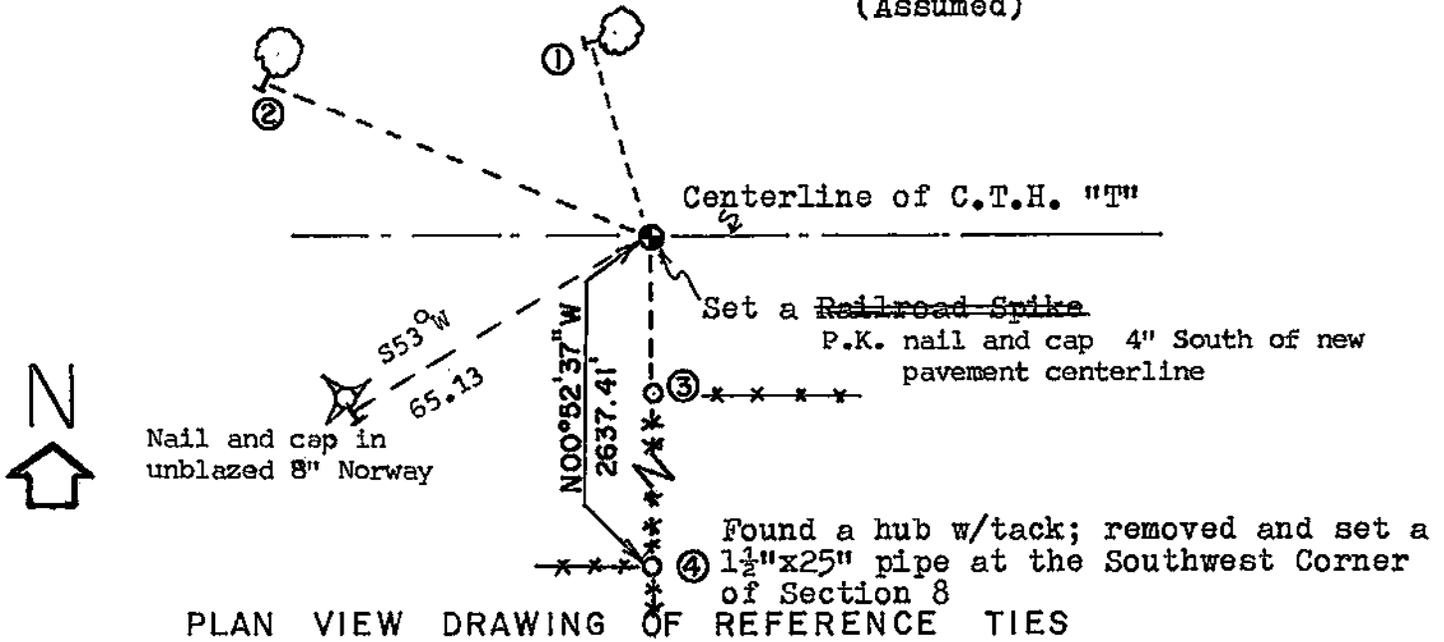

MAP SHOWING DISTANCE AND DIRECTION TO OTHER PUBLIC LAND SURVEY CORNERS USED FOR REESTABLISHING THE CORNER

Note: See above plan view drawing.

I, William C. Jung, Deputy County Surveyor,  
HEREBY CERTIFY THAT THE CORNER LOCATION SHOWN ON THIS RECORD  
WAS DETERMINED BY ME OR UNDER MY DIRECTION AND CONTROL AND  
THAT THIS U. S. PUBLIC LAND SURVEY MONUMENT RECORD IS CORRECT  
AND COMPLETE TO THE BEST OF MY KNOWLEDGE AND BELIEF.

William C. Jung  
Signature

10/28/85

Date

Revised: 12/2/05 *WCF*

