


U. S. PUBLIC LAND SURVEY MONUMENT RECORD

SECTION 8 T 18 N, R 7 W, TOWN OF Holland

LA CROSSE COUNTY

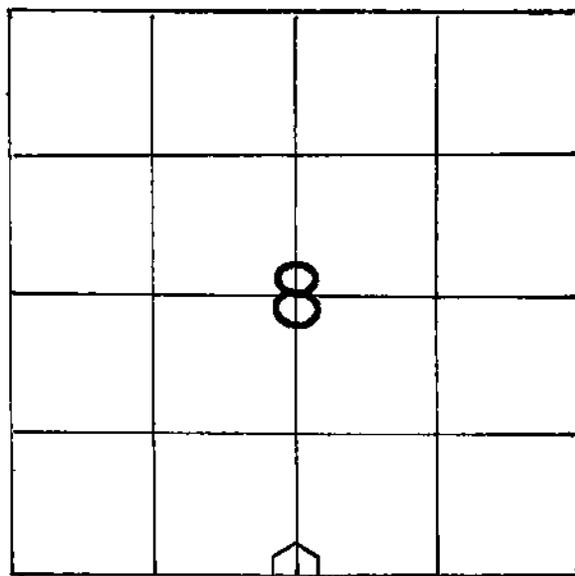

LOCATION OF LANDMARK

WISCONSIN COORDINATE SYSTEM
North
East
Theta Angle
Horiz. Order
Vert. Order
TYPE OF LANDMARK
Brass capped Lunde marker
BEARINGS ARE REFERENCED TO
Assumed

Crew: William C. Jung  
Peter F. Follansbee

Date: March 1, 1994

Describe any record evidence, monument evidence, testimonial evidence or any other material evidence you considered and whether the monument was found or restored through acceptance of an obliterated evidence location.

I set this corner on line between the section corners and in the old North-South line fence. Given the field evidence, I felt that this was the best method versus single proportionate measurement. I set a brass capped Lunde marker at the corner.


Describe or show any material discrepancy between the location of the restored corner and that of the corner previously restored or reestablished.

None known.

RECORD OF DURABLE WITNESS MONUMENTS


MAGNETIC

NO	DESCRIPTION	BEARING	DISTANCE
1	Set P.K. Nail in NE-side 6" Norway	N 47° W	36.02 Ft.
2	Set P.K. Nail in SW-side 5" Norway	N 60° W	29.55 Ft.
3	Set P.K. Nail in N.-side 5" Norway	S 86° W	25.50 Ft.
4	Existing Iron Bar under fence (my survey point)	South ±	14.55 Ft.

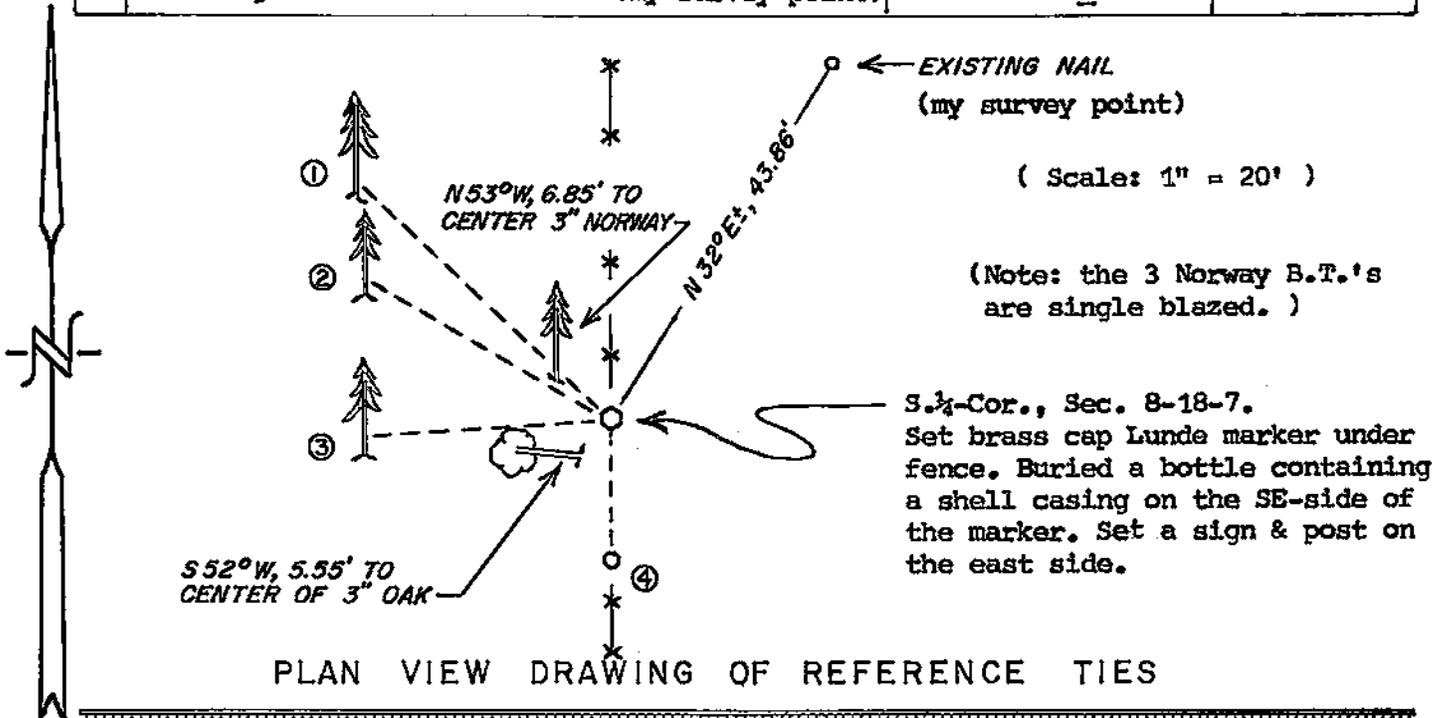


MAP SHOWING DISTANCE AND DIRECTION TO OTHER PUBLIC LAND SURVEY CORNERS USED FOR REESTABLISHING THE CORNER

(not to scale)

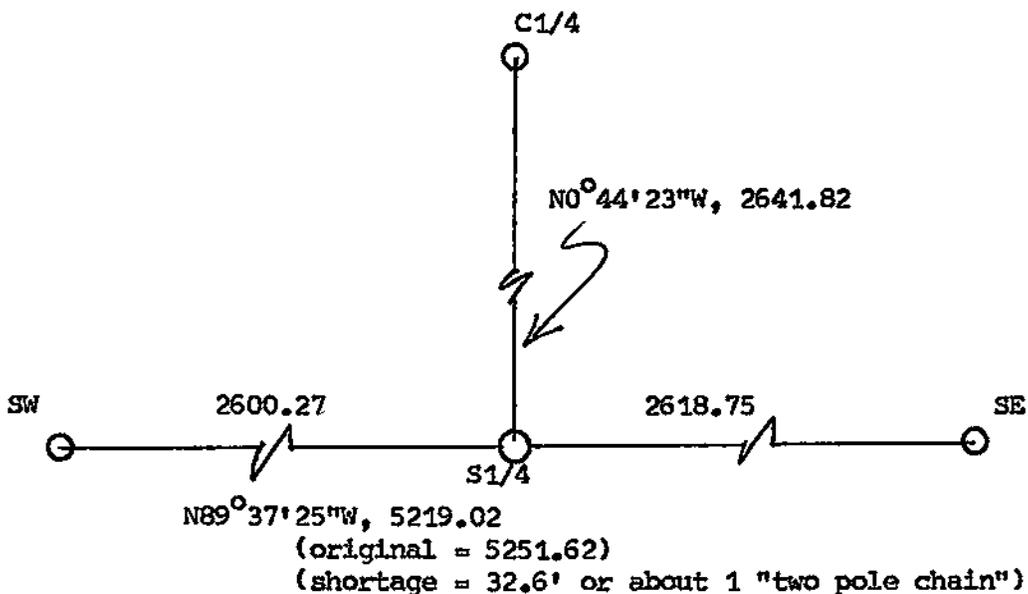

I, William C. Jung, County Surveyor,  
 HEREBY CERTIFY THAT THE CORNER LOCATION SHOWN ON THIS RECORD  
 WAS DETERMINED BY ME OR UNDER MY DIRECTION AND CONTROL AND  
 THAT THIS U. S. PUBLIC LAND SURVEY MONUMENT RECORD IS CORRECT  
 AND COMPLETE TO THE BEST OF MY KNOWLEDGE AND BELIEF.

William C. Jung April 26, 1994  
 Signature Date

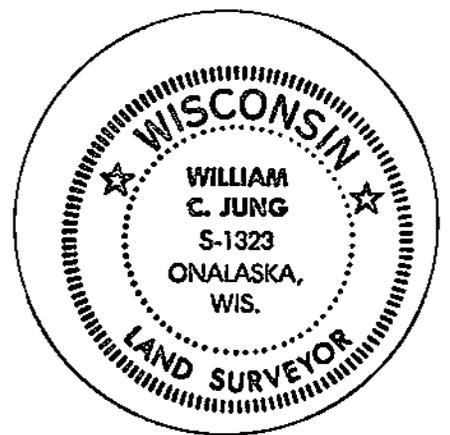

Seal