


21807082000

U. S. PUBLIC LAND SURVEY MONUMENT RECORD

SECTION 9 T 18 N, R 7 W, TOWN OF HOLLAND

LA CROSSE COUNTY

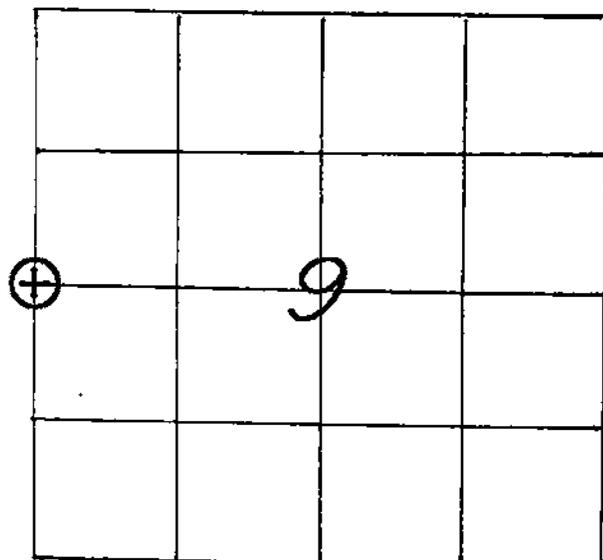

LOCATION OF LANDMARK

CREW: WILLIAM G. JUNG
 PETER F. FOLLANSBEE
 DATE: 10/17/2005

WISCONSIN COORDINATE SYSTEM	
North	749,375.282
East	1,644,729.638
Theta Angle	
Horiz. Order	
Vert. Order	
DATUM:	1983('91)
TYPE OF LANDMARK	
3/4" x 30" IRON BAR WITH AN ALUMINUM CAP.	
BEARINGS ARE REFERENCED TO	
GRID NORTH AS PER SECTION DATA.	

Describe any record evidence, monument evidence, testimonial evidence or any other material evidence you considered and whether the monument was found or restored through acceptance of an obliterated evidence location.

I found the pipe that we set back in 1989, down 12" and buried in a gravel driveway. I drove an iron pipe with a cap inside of our old iron pipe.


(See my 1989 tie sheet for more information.)

Describe or show any material discrepancy between the location of the restored corner and that of the corner previously restored or reestablished.

NONE KNOWN.


RECORD OF DURABLE WITNESS MONUMENTS

NO	DESCRIPTION	MAGNETIC BEARING	DISTANCE
1	SET A NAIL IN W.-SIDE OF A 5-1/4" OAK	N 02° E	50.37 FT.
2	SET A NAIL IN N.W.-SIDE OF A 6-1/2" OAK	N 65° E	32.13 FT.
3	SET A NAIL IN S.-SIDE OF A 6-1/2" OAK	EAST ±	41.35 FT.
4	EX. 1-1/2" IRON PIPE AT THE ROAD P.I.	S 17° E	10.50 FT.

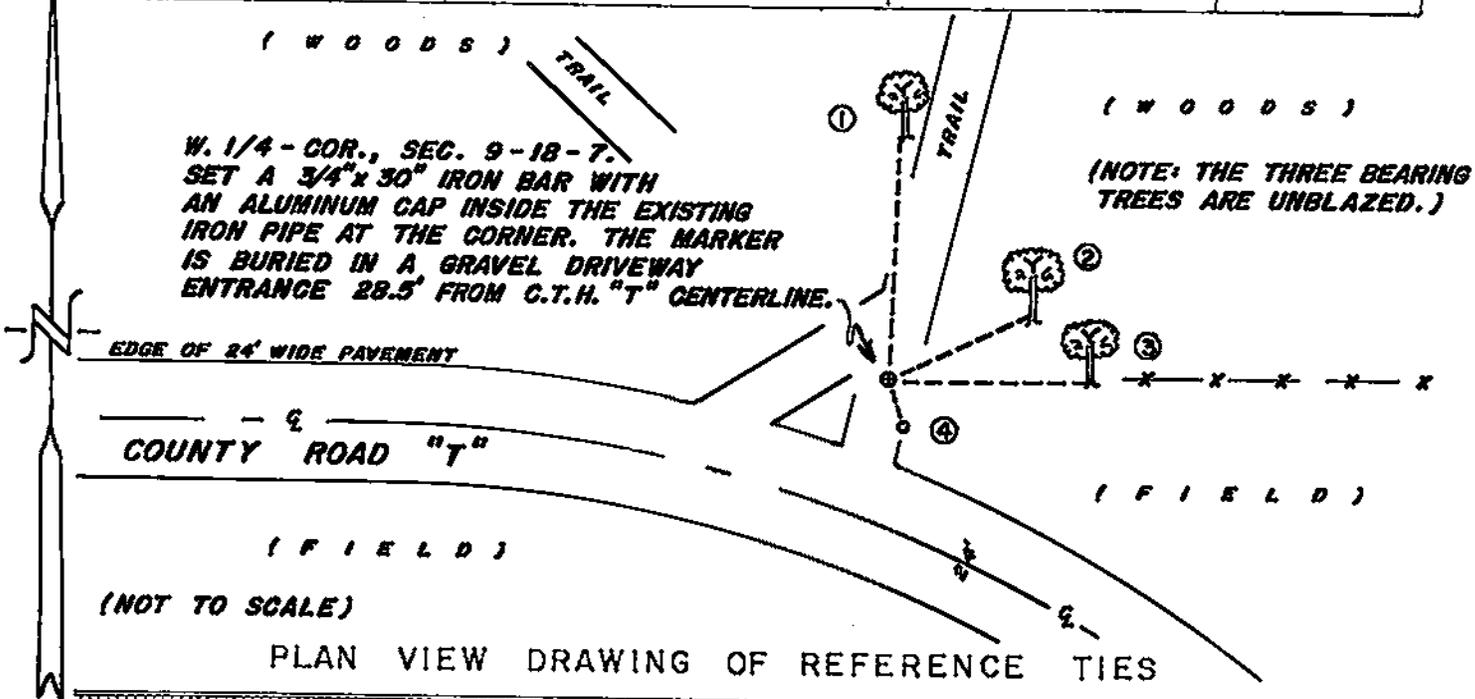

MAP SHOWING DISTANCE AND DIRECTION TO OTHER PUBLIC LAND SURVEY CORNERS USED FOR REESTABLISHING THE CORNER


(GRID BEARINGS AND DISTANCES)
(GRID FACTOR: 0.999965661)
(NOT TO SCALE)

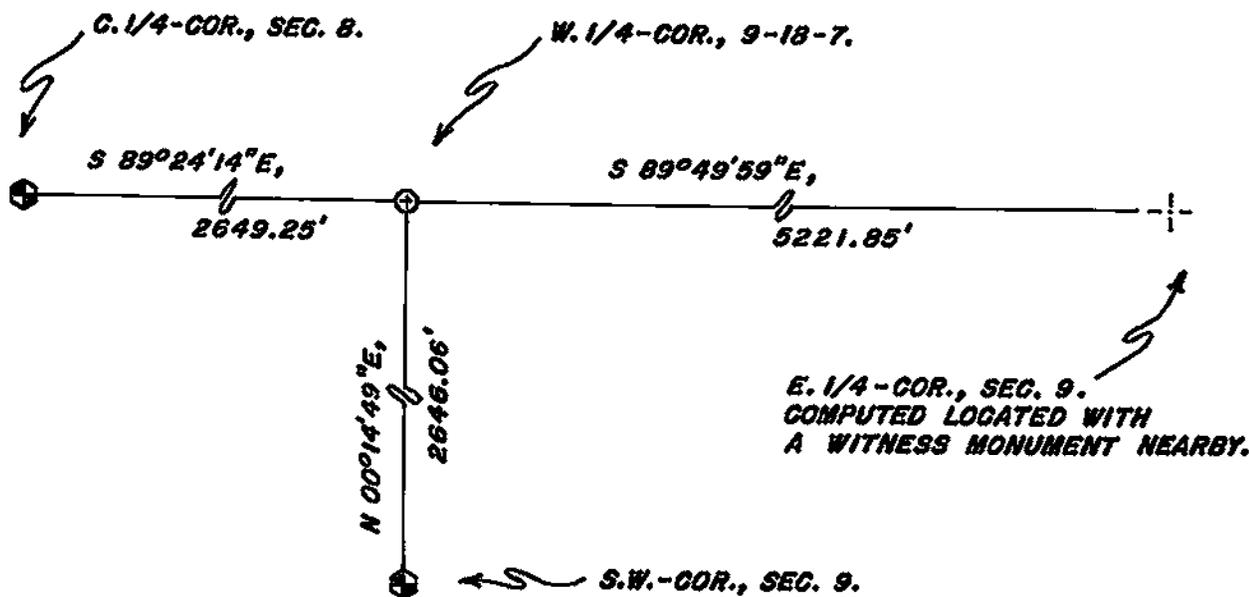

I, WILLIAM C. JUNG, COUNTY SURVEYOR
HEREBY CERTIFY THAT THE CORNER LOCATION SHOWN ON THIS RECORD WAS DETERMINED BY ME OR UNDER MY DIRECTION AND CONTROL AND THAT THIS U. S. PUBLIC LAND SURVEY MONUMENT RECORD IS CORRECT AND COMPLETE TO THE BEST OF MY KNOWLEDGE AND BELIEF.

William C. Jung
Signature

12/21/05
Date

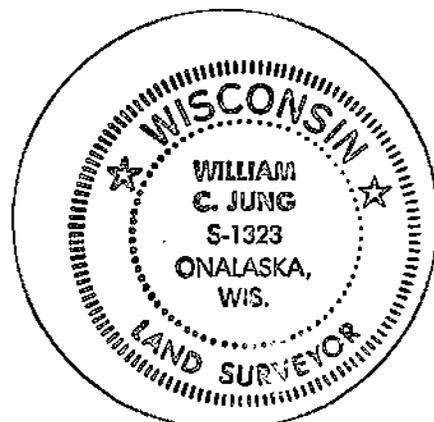


Seal

U. S. PUBLIC LAND SURVEY MONUMENT RECORD

SECTION 9 T 18 N, R 7 W, TOWN OF Holland

LA CROSSE COUNTY

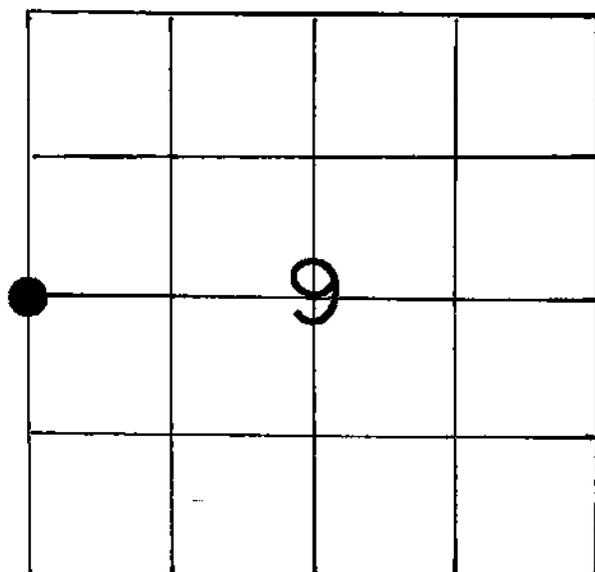

LOCATION OF LANDMARK

WISCONSIN COORDINATE SYSTEM

North

East

Theta Angle

Horiz. Order

Vert. Order

TYPE OF LANDMARK

Set 1" x 28" Iron Pipe

BEARINGS ARE REFERENCED TO

Assumed

Crew: WILLIAM C. JUNG
PETER F. FOLLANSBEE

Date: 12/01/1989

Describe any record evidence, monument evidence, testimonial evidence or any other material evidence you considered and whether the monument was found or restored through acceptance of an obliterated evidence location.

After analyzing the evidence found in Section 9, Berg's data from Section 8, and the 1939 highway map of C.T.H. "T", I set a 1" iron pipe at the computed 1/4 corner location.


Describe or show any material discrepancy between the location of the restored corner and that of the corner previously restored or reestablished.

NONE KNOWN

RECORD OF DURABLE WITNESS MONUMENTS


NO	DESCRIPTION	BEARING	DISTANCE
1	Set P.K. Nail in SW-side 6" Oak(unblzd)	Mag.= N 40°W	38.04 Ft.
2	Ex. 1½" iron pipe	-----	15.96 Ft.
3	Ex. 1½" iron pipe (at road P.I.)	Assumed = S16°40'37"E	10.50 Ft.
4	Ex. P.K. Nail in pavement, C.T.H. "T"	Assumed = S23°36'16"W	30.33 Ft.

Note: Pipe's no. 2 & 3 were set as survey points in October of 1985 by W.C. Jung.

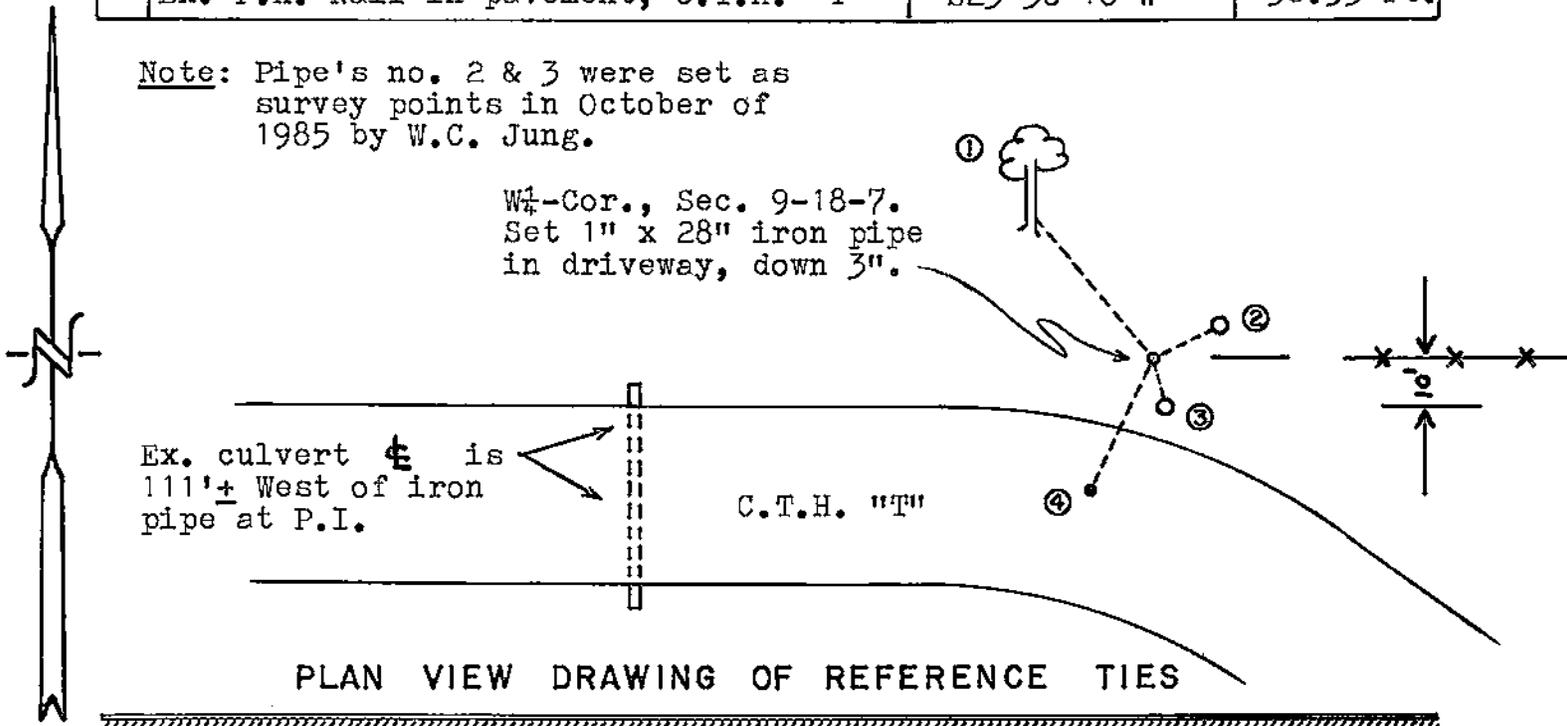

MAP SHOWING DISTANCE AND DIRECTION TO OTHER PUBLIC LAND SURVEY CORNERS USED FOR REESTABLISHING THE CORNER


(not to scale)

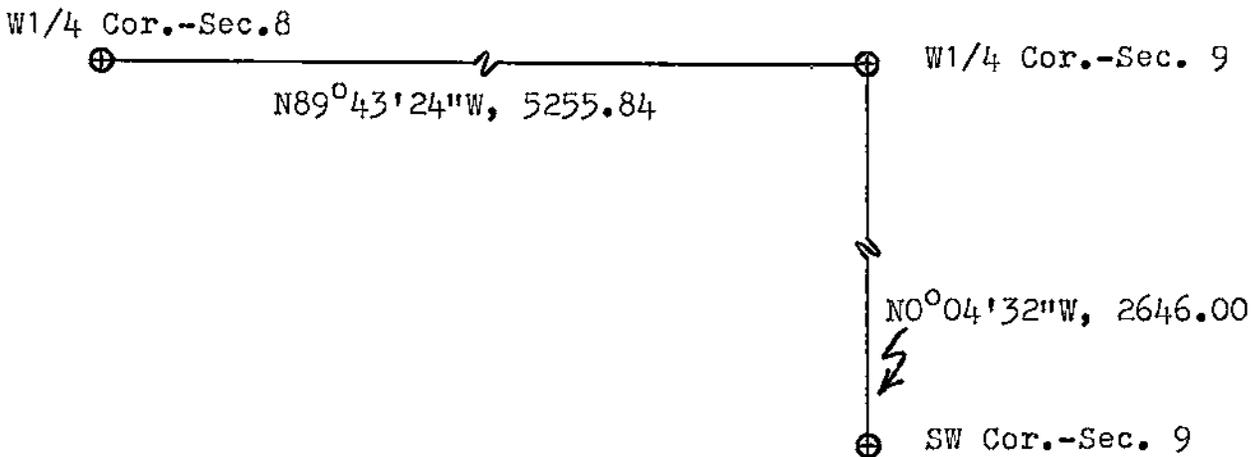

I, William C. Jung, deputy county surveyor
 HEREBY CERTIFY THAT THE CORNER LOCATION SHOWN ON THIS RECORD
 WAS DETERMINED BY ME OR UNDER MY DIRECTION AND CONTROL AND
 THAT THIS U. S. PUBLIC LAND SURVEY MONUMENT RECORD IS CORRECT
 AND COMPLETE TO THE BEST OF MY KNOWLEDGE AND BELIEF.

William C. Jung
 Signature

January 5, 1990
 Date

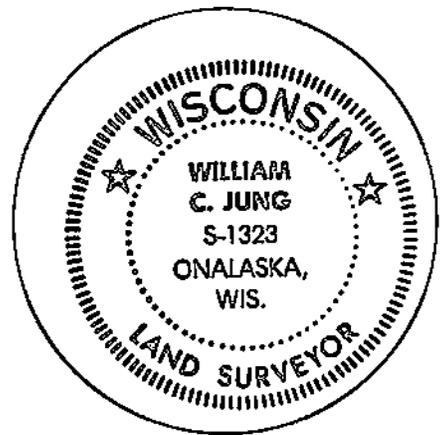

Seal