


21807090020

U. S. PUBLIC LAND SURVEY MONUMENT RECORD

SECTION 9 T 18 N, R 7 W, TOWN OF HOLLAND

LA CROSSE COUNTY

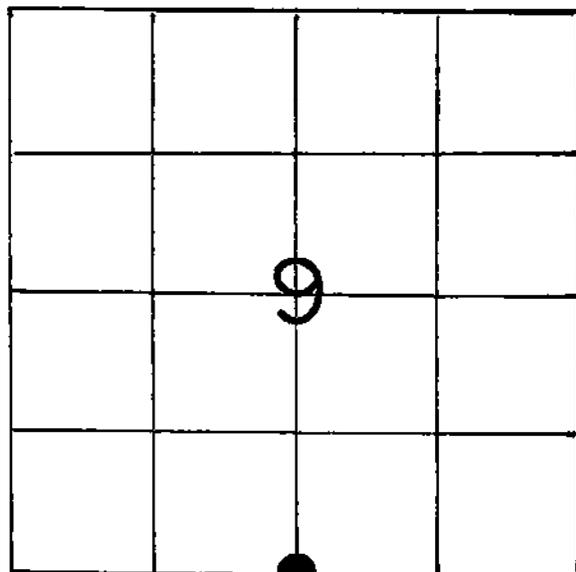

LOCATION OF LANDMARK

WISCONSIN COORDINATE SYSTEM

North

East

Theta Angle

Horiz. Order

Vert. Order

TYPE OF LANDMARK

Set Brass Cap Lunde marker

BEARINGS ARE REFERENCED TO

Assumed

Crew: WILLIAM C. JUNG
PETER F. FOLLANSBEE

Date: 11/13/1989

Describe any record evidence, monument evidence, testimonial evidence or any other material evidence you considered and whether the monument was found or restored through acceptance of an obliterated evidence location.

I feel that the old 44" burr oak to the Northwest is the original bearing tree and set a brass capped Lunde at the corner by using this tree.

Describe or show any material discrepancy between the location of the restored corner and that of the corner previously restored or reestablished.

NONE KNOWN


**RECORD OF DURABLE WITNESS MONUMENTS
MAGNETIC**

NO	DESCRIPTION	BEARING	DISTANCE
1	Set 8" nail in 44" Burr Oak(Orig. B.T.)	N 61°W	14.65 ft.
2	Set P.K. Nail in 15" Norway pine	N 07°E	95.84 ft.
3	Set P.K. Nail in 44" Burr Oak	S 54°E	95.91 ft.
4	Set P.K. Nail in 7" Cedar	S 05°E	24.24 ft.

NOTE: All trees are unblazed except the Norway which is single blazed.


W O O D E D

F I E L D

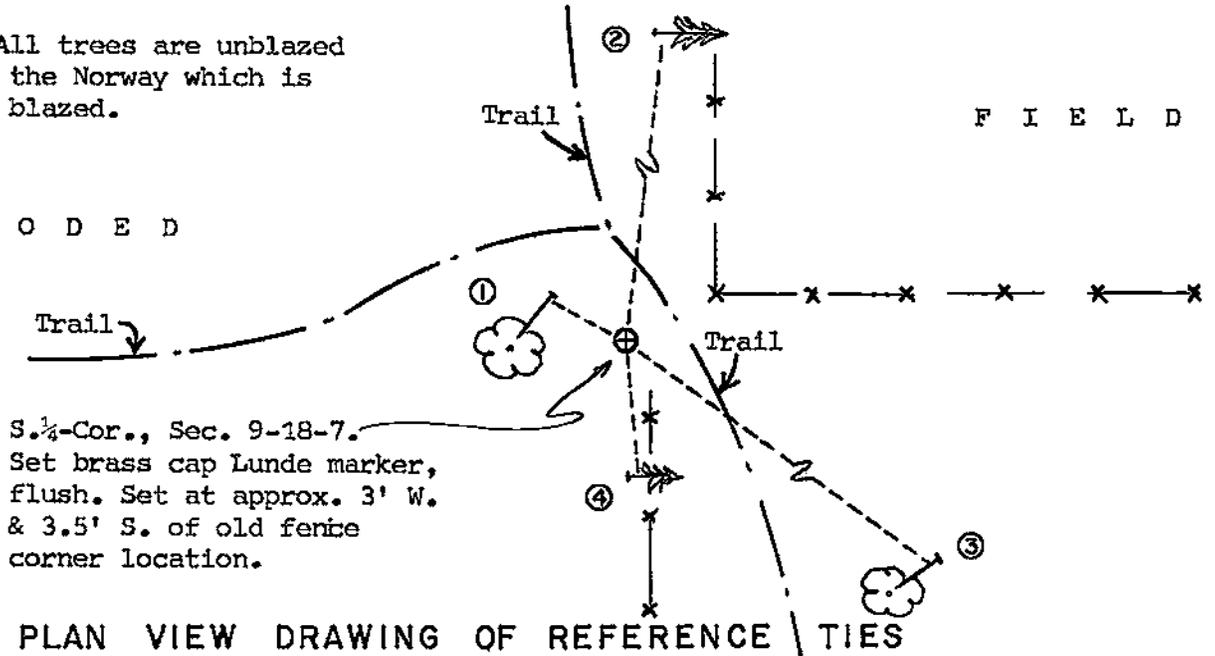

MAP SHOWING DISTANCE AND DIRECTION TO OTHER PUBLIC LAND SURVEY CORNERS USED FOR REESTABLISHING THE CORNER

(not to scale)

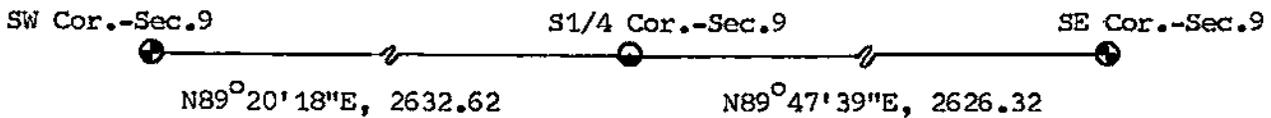

I, William C. Jung, Deputy County Surveyor
HEREBY CERTIFY THAT THE CORNER LOCATION SHOWN ON THIS RECORD
WAS DETERMINED BY ME OR UNDER MY DIRECTION AND CONTROL AND
THAT THIS U. S. PUBLIC LAND SURVEY MONUMENT RECORD IS CORRECT
AND COMPLETE TO THE BEST OF MY KNOWLEDGE AND BELIEF.

William C. Jung
Signature

January 5, 1990
Date



Seal