


21807092000

U. S. PUBLIC LAND SURVEY MONUMENT RECORD

SECTION 10 T 18 N, R 7 W, TOWN OF FARMINGTON

LA CROSSE COUNTY

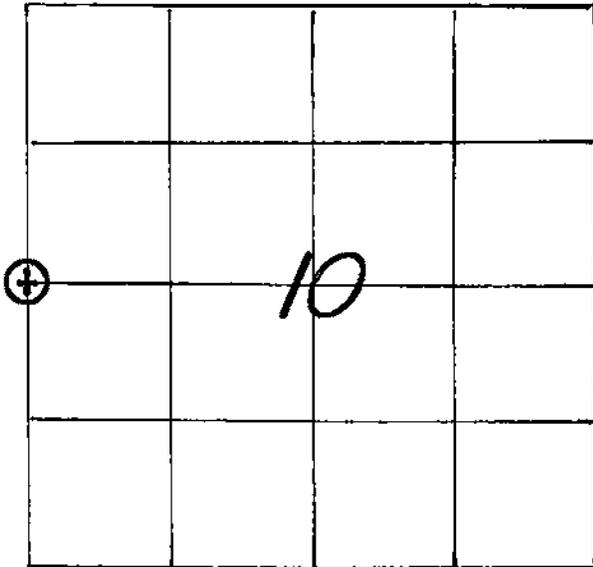

WISCONSIN COORDINATE SYSTEM
North
East
Theta Angle
Horiz. Order
Vert. Order

TYPE OF LANDMARK  
 3/4" x 30" IRON BAR WITH ALUMINUM CAP. \*\*\*\*

BEARINGS ARE REFERENCED TO GRID  
~~THE LA CROSSE COUNTY~~  
~~COORDINATE SYSTEM.~~

LOCATION OF LANDMARK

CREW: WILLIAM C. JUNG  
 PETER F. FOLLANSBEE  
 DATE: 10/04/2001

Crew: William C. Jung  
 Peter Follansbee  
 Date: 3/7/02

\*\*\*\*located 1.015 feet South  
 and 0.953 feet East of  
 the true corner

Describe any record evidence, monument evidence, testimonial evidence or any other material evidence you considered and whether the monument was found or restored through acceptance of an obliterated evidence location.

After discussing this <sup>corner</sup> at length and inspecting the field evidence, Paul Fairchild and I decided to set this corner by single proportionate measurement. I removed his nail at the corner and replaced it with an iron bar and cap and buried it in the field. I later learned that the nail was set in the wrong location and is now a witness corner. The true corner is 1.015 feet North and 0.953 feet West of the bar and cap.

Describe or show any material discrepancy between the location of the restored corner and that of the corner previously restored or reestablished.

At first glance and after checking surveys on file, this location may not fit the computed location as shown on 1983 maps from LaCrosse Engineering.

