


21807100020

U. S. PUBLIC LAND SURVEY MONUMENT RECORD

SECTION 10 T 18 N, R 7 W, TOWN OF FARMINGTON  
 LA CROSSE COUNTY

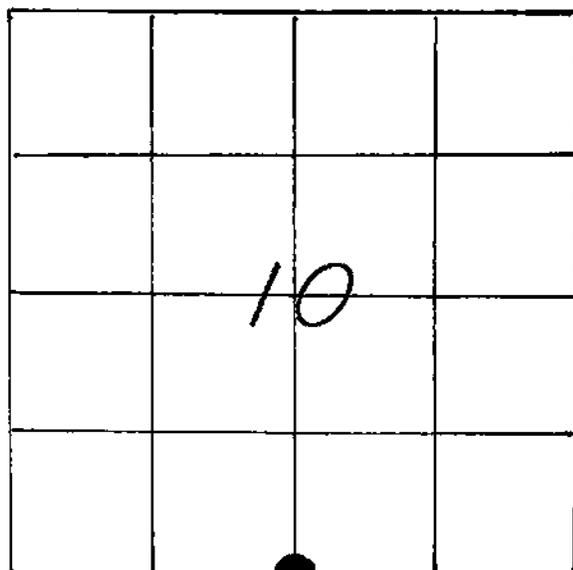

LOCATION OF LANDMARK

Crew: William C. Jung  
 Peter F.FOLLANSBEE  
 Date: 7/14/1997

Crew: William C. Jung  
 Peter F.Follansbee  
 Date: 6/13/05 and 10/17/05

WISCONSIN COORDINATE SYSTEM
North
East
Theta Angle
Horiz. Order
Vert. Order

TYPE OF LANDMARK  
~~1/2" x 12" Iron Bar~~ P.K. nail and cap

BEARINGS ARE REFERENCED TO

Describe any record evidence, monument evidence, testimonial evidence or any other material evidence you considered and whether the monument was found or restored through acceptance of an obliterated evidence location.

I removed the existing P.K. nail at the occupied corner and replaced it with a 1/2" x 12" iron bar. This P.K. nail had been used as the corner in previous survey work. I accepted this location as the best available evidence of the original government corner position.

2005 - The iron bar was knocked out due to a repaving project. I set a P.K. nail and cap at the corner 0.9 ft. North of the new pavement centerline.

Describe or show any material discrepancy between the location of the restored corner and that of the corner previously restored or reestablished.


None Known.

\*\*\*\*\* 2005

There is a 12" spike 20.37 feet to the Southwest of the corner and 14.5 feet South of the centerline and another 12" nail(spike) 22.4 feet to the Southeast of the corner and 15 feet South of the centerline.

RECORD OF DURABLE WITNESS MONUMENTS  
MAGNETIC


NO	DESCRIPTION	BEARING	DISTANCE
1	Set 7/8" x 23" round Iron Bar	Northwesterly±	48.28 Ft.
2	Set nail in SE-side 6½" Oak	N 35°E	33.82 Ft.
3	Set nail in SE-side 6" Oak	N 48°E	39.97 Ft.
4	Set nail in SE-side 5½" double Oak	N 65°E	67.11 Ft.

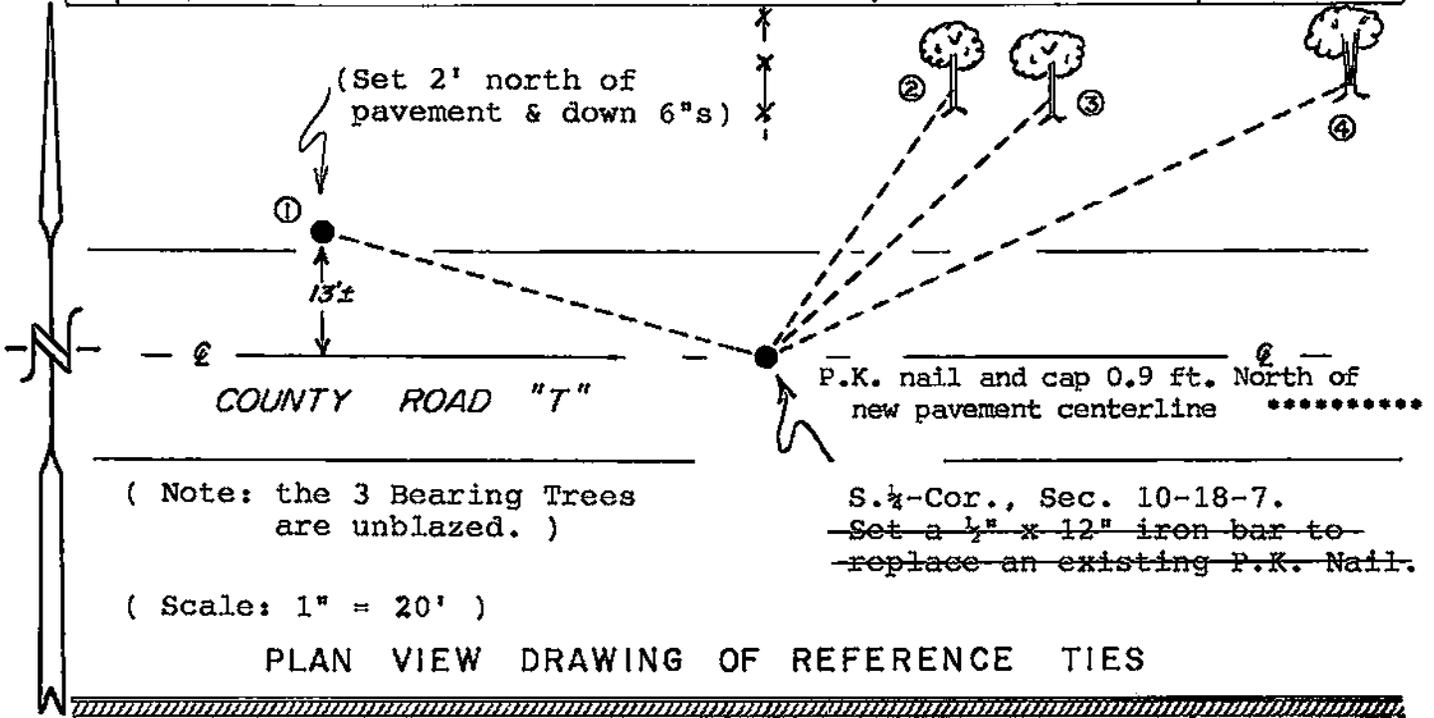

S.¼-Cor., Sec. 10-18-7.  
~~Set a ½" x 12" iron bar to replace an existing P.K. Nail.~~

MAP SHOWING DISTANCE AND DIRECTION TO OTHER PUBLIC LAND SURVEY CORNERS USED FOR REESTABLISHING THE CORNER


(not to scale)

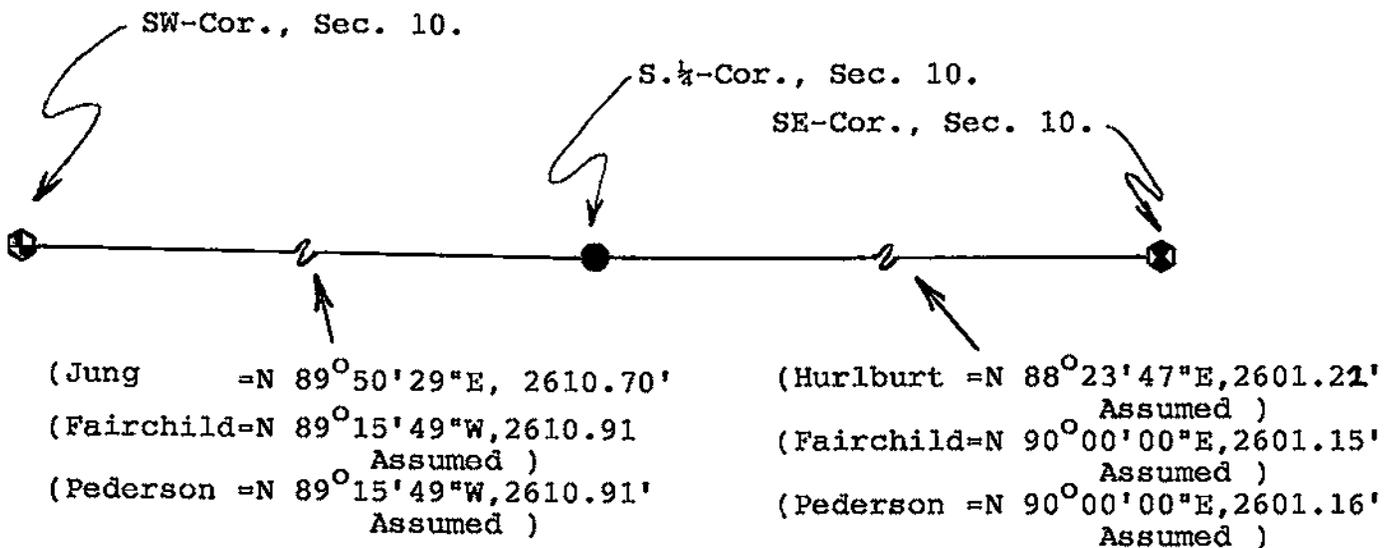

I, William C. Jung, County Surveyor  
HEREBY CERTIFY THAT THE CORNER LOCATION SHOWN ON THIS RECORD WAS DETERMINED BY ME OR UNDER MY DIRECTION AND CONTROL AND THAT THIS U. S. PUBLIC LAND SURVEY MONUMENT RECORD IS CORRECT AND COMPLETE TO THE BEST OF MY KNOWLEDGE AND BELIEF.

William C. Jung 1/13/98  
Signature Date

Revised: 12/5/05 *awc*

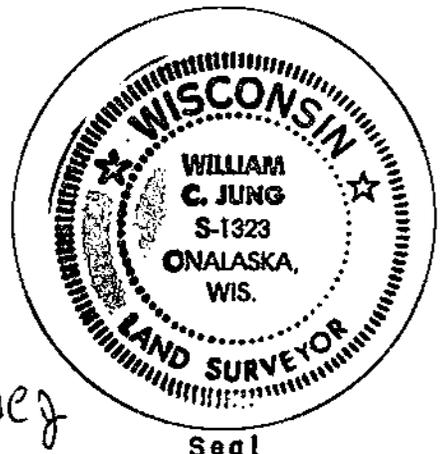

Seal