


U. S. PUBLIC LAND SURVEY MONUMENT RECORD

SECTION 11 T 18 N, R 7 W, TOWN OF Farmington
 LA CROSSE COUNTY

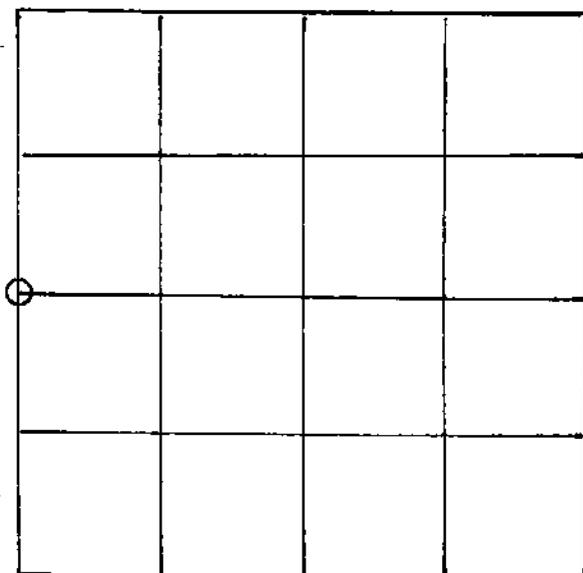

LOCATION OF LANDMARK

WISCONSIN COORDINATE SYSTEM
North
East
Theta Angle
Horiz. Order
Vert. Order
TYPE OF LANDMARK
1 1/2" Iron Pipe Found
BEARINGS ARE REFERENCED TO
True

Describe any record evidence, monument evidence, testimonial evidence or any other material evidence you considered and whether the monument was found or restored through acceptance of an obliterated evidence location.


1 1/2 Iron Pipe Monument was found on old, down East - West fence line
 Location agrees with previous section data done by LESCO. It also fits
 the 40 corner fence corner, east of the Quarter Corner, East & West.
 The origin of Monument is not known by me.

Describe or show any material discrepancy between the location of the restored corner and that of the corner previously restored or reestablished.

None Known


RECORD OF DURABLE WITNESS MONUMENTS

NO	DESCRIPTION	BEARING	DISTANCE
1	Set nail in 2.5' dia Maple	Westerly	6.0'
2	Set spike in 1.5' dia Spruce	Easterly	29.0'
3	Set spike in 1.0' dia Ash	Southerly	23.0'
4	Set spike in 1.5' dia Oak	Northerly	24.0'

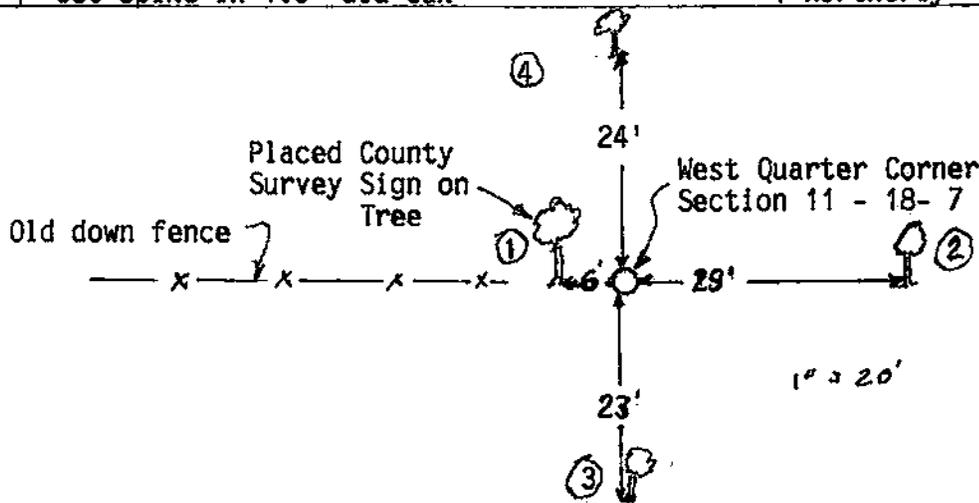

PLAN VIEW DRAWING OF REFERENCE TIES

MAP SHOWING DISTANCE AND DIRECTION TO OTHER PUBLIC LAND SURVEY CORNERS USED FOR REESTABLISHING THE CORNER

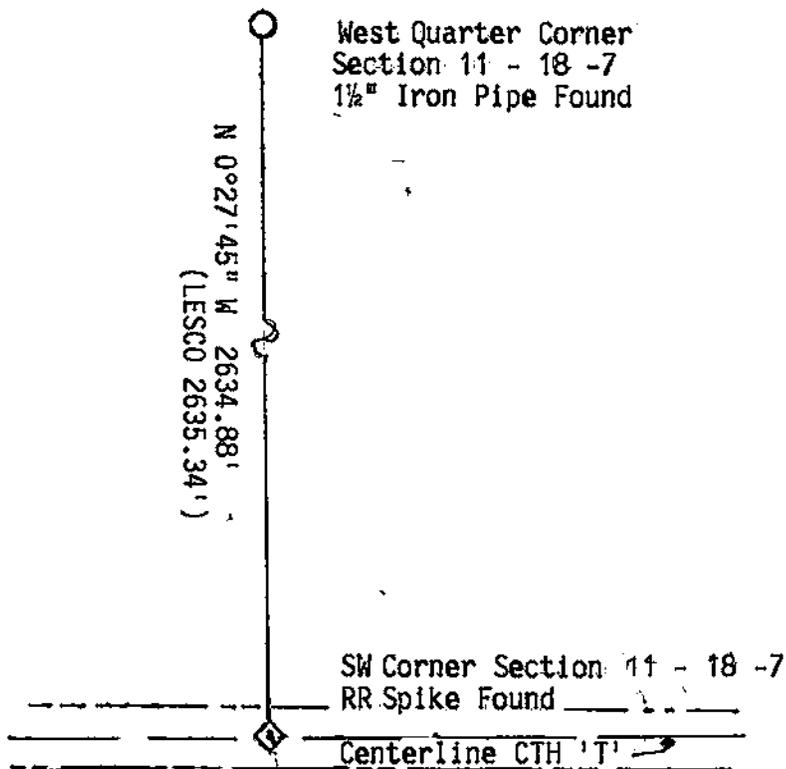

I, Philip Scholze - RLS 1493

HEREBY CERTIFY THAT THE CORNER LOCATION SHOWN ON THIS RECORD WAS DETERMINED BY ME OR UNDER MY DIRECTION AND CONTROL AND THAT THIS U. S. PUBLIC LAND SURVEY MONUMENT RECORD IS CORRECT AND COMPLETE TO THE BEST OF MY KNOWLEDGE AND BELIEF.

Philip Scholze
Signature

4-07-06
Date



Seal