


21807110000

U. S. PUBLIC LAND SURVEY MONUMENT RECORD

SECTION 13 T 18 N, R 7 W, TOWN OF FARMINGTON  
 LA CROSSE COUNTY

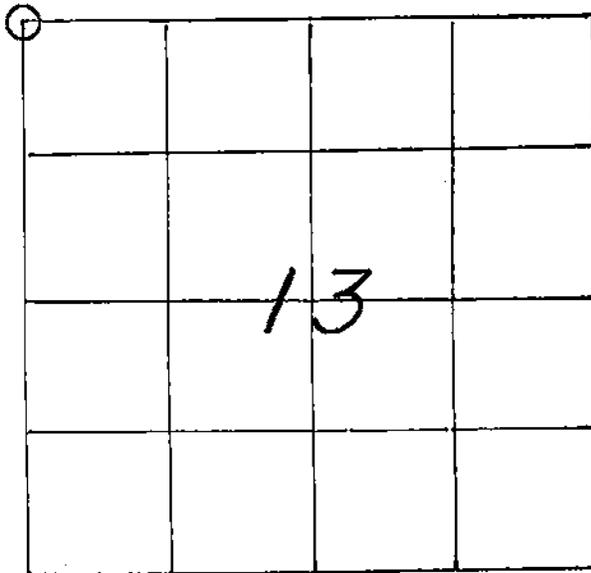

LOCATION OF LANDMARK

Crew: William C. Jung  
 Peter F. Follansbee

Date: 9/15/98

Describe any record evidence, monument evidence, testimonial evidence or any other material evidence you considered and whether the monument was found or restored through acceptance of an obliterated evidence location.

I again found the iron pipe that I used in 1987. Three of my 1987 bearing trees were destroyed by one of our bad storms this year. Three new trees were blazed and a sign and post were set. This pipe has been used as the corner in more survey work since 1987.

Describe or show any material discrepancy between the location of the restored corner and that of the corner previously restored or reestablished.


None known.

WISCONSIN COORDINATE SYSTEM
North
East
Theta Angle
Horiz. Order
Vert. Order
TYPE OF LANDMARK
Existing 1/4" iron pipe
BEARINGS ARE REFERENCED TO
<i>ASSUMED NORTH.</i>

RECORD OF DURABLE WITNESS MONUMENTS

MAGNETIC


NO	DESCRIPTION	BEARING	DISTANCE
1	EXISTING P.K. NAIL IN AN 8" WHITE OAK (DOUBLE BLAZED)	S 25° W	35.60 FT.
2	SET A NAIL IN THE S.-SIDE 10-1/2" W. OAK (DOUBLE BLAZED)	N 70° W	26.03 FT.
3	SET A NAIL IN THE S.E.-SIDE 11" W. OAK (DOUBLE BLAZED)	N 12° E	18.19 FT.
4	SET A NAIL IN THE N.W.-SIDE 6" W. OAK (DOUBLE BLAZED)	N 46° E	21.25 FT.

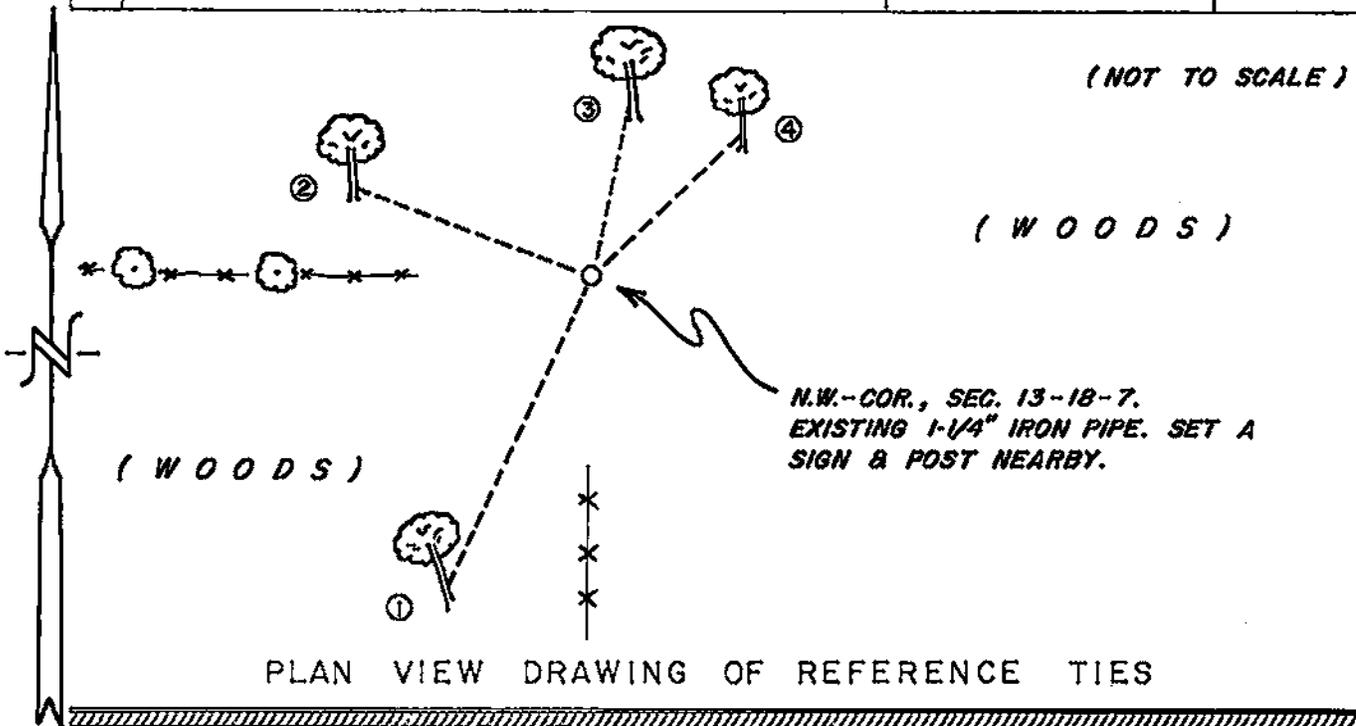

PLAN VIEW DRAWING OF REFERENCE TIES


MAP SHOWING DISTANCE AND DIRECTION TO OTHER PUBLIC LAND SURVEY CORNERS USED FOR REESTABLISHING THE CORNER

(not to scale)

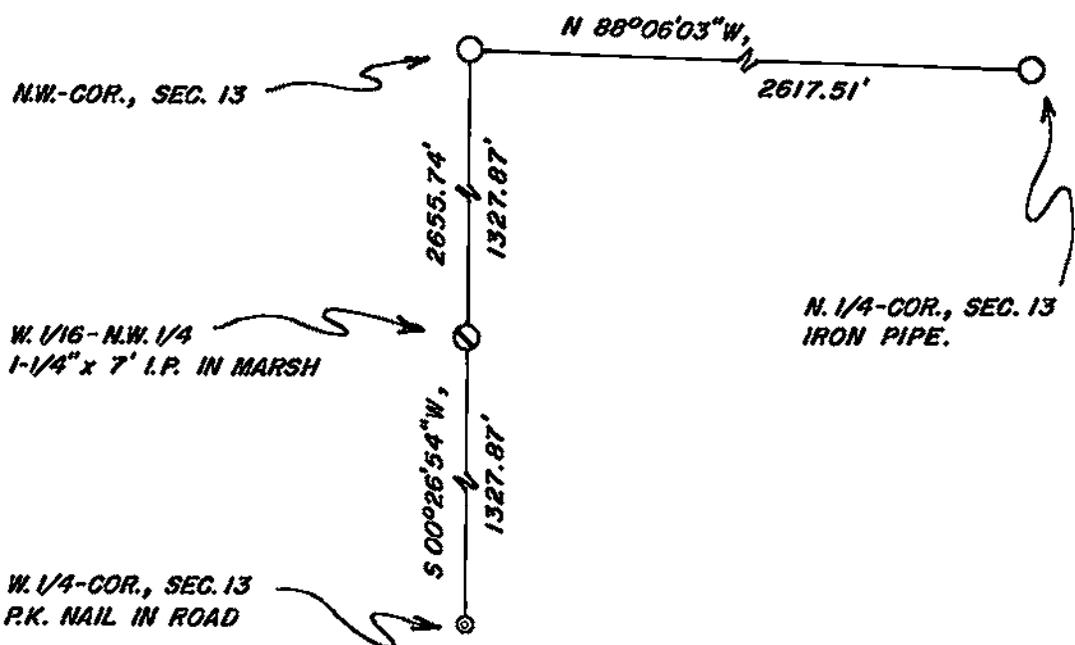

I, WILLIAM C. JUNG, COUNTY SURVEYOR  
 HEREBY CERTIFY THAT THE CORNER LOCATION SHOWN ON THIS RECORD  
 WAS DETERMINED BY ME OR UNDER MY DIRECTION AND CONTROL AND  
 THAT THIS U. S. PUBLIC LAND SURVEY MONUMENT RECORD IS CORRECT  
 AND COMPLETE TO THE BEST OF MY KNOWLEDGE AND BELIEF.


William C. Jung 12/23/98  
 Signature Date

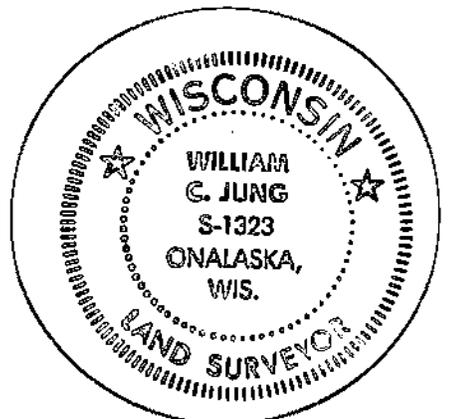

Seal

U. S. PUBLIC LAND SURVEY MONUMENT RECORD

SECTION 12 T 18 N, R 7 W, TOWN OF FARMINGTON  
 LA CROSSE COUNTY.

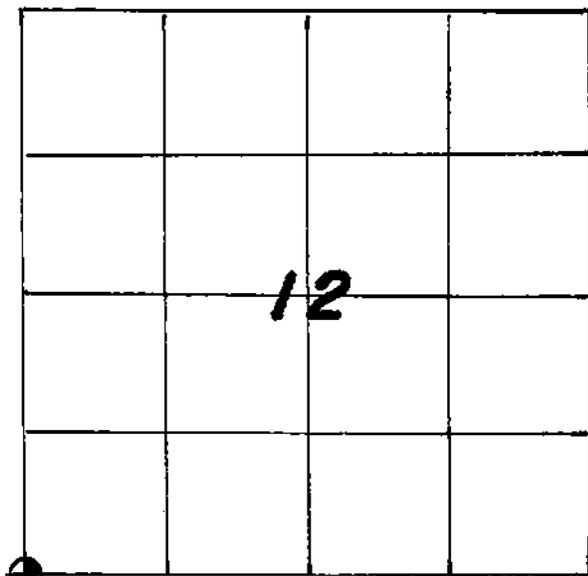

LOCATION OF LANDMARK

CREW: PERRY DAHL, BILL JUNG

DATE: 3-3-87

WISCONSIN COORDINATE SYSTEM
North
East
Theta Angle
Horiz. Order
Vert. Order
TYPE OF LANDMARK
1 1/4" IRON PIPE
BEARINGS ARE REFERENCED TO ASSUMED

Describe any record evidence, monument evidence, testimonial evidence or any other material evidence you considered and whether the monument was found or restored through acceptance of an obliterated evidence location.

I found an iron pipe set by Ray Hengel at the occupied fence corner in 1983. I accepted this pipe as the best available evidence of the original government corner position.

Describe or show any material discrepancy between the location of the restored corner and that of the corner previously restored or reestablished.

None known.

VOID

