


21807110020

## U. S. PUBLIC LAND SURVEY MONUMENT RECORD

SECTION 14 T 18 N, R 7 W, TOWN OF FARMINGTON

LA CROSSE COUNTY

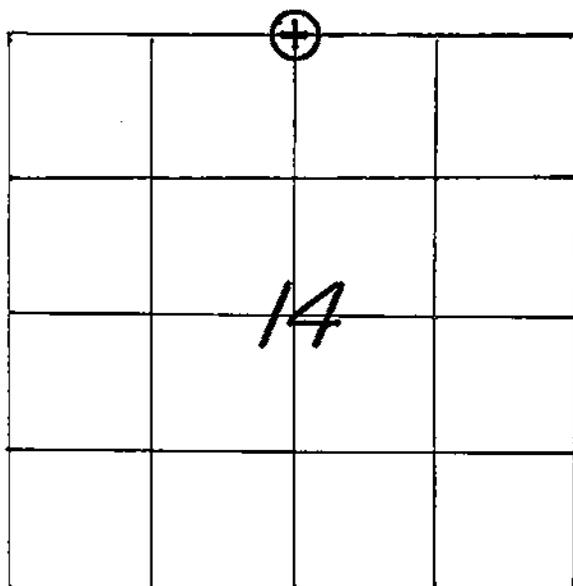

WISCONSIN COORDINATE SYSTEM

North

East

Theta Angle

Horiz. Order

Vert. Order

TYPE OF LANDMARK

**3/4" x 30" IRON BAR WITH ALUMINUM CAP.**

BEARINGS ARE REFERENCED TO

**ASSUMED NORTH AS PER SECTION DATA.**

LOCATION OF LANDMARK

CREW: **WILLIAM C. JUNG**  
**PETER F. FOLLANSBEE**  
 DATE: **1/08/2003**

Describe any record evidence, monument evidence, testimonial evidence or any other material evidence you considered and whether the monument was found or restored through acceptance of an obliterated evidence location.


In 1983 Ray Hengel surveyed out Sections 10 and 11 and came up with a position for this 1/4 corner. His section data indicated that it fell at the occupied corner. In 1996, Rodney Maxwell, and then in 2001, Mike Harding, both used this corner as a tie at its calculated position. No monument was set. I have no record either that Hengel set an actual monument. None was found. Norm Hurlburt calculated the location of this corner based on Harding's survey. I set this corner using Hurlburt's computations and survey points. I set an iron bar and cap at the corner. It appears to fit the old occupation. Describe or show any material discrepancy between the location of the restored corner and that of the corner previously restored or reestablished.

**NONE KNOWN.**


RECORD OF DURABLE WITNESS MONUMENTS

MAGNETIC

NO	DESCRIPTION	BEARING	DISTANCE
1	SET A NAIL IN S.-SIDE OF A 4" HAWTHORN ?	N 88° W	12.66 FT.
2	SET A NAIL IN S.E.-SIDE OF A 4-3/4" HAWTHORN ?	S 58° W	22.17 FT.
3	SET A NAIL IN N.W.-SIDE OF A 6" HAWTHORN ?	S 08° W	10.22 FT.
4	SET A NAIL IN S.W.-SIDE OF AN 11-1/2" HAWTHORN ?	S 44° E	15.71 FT.

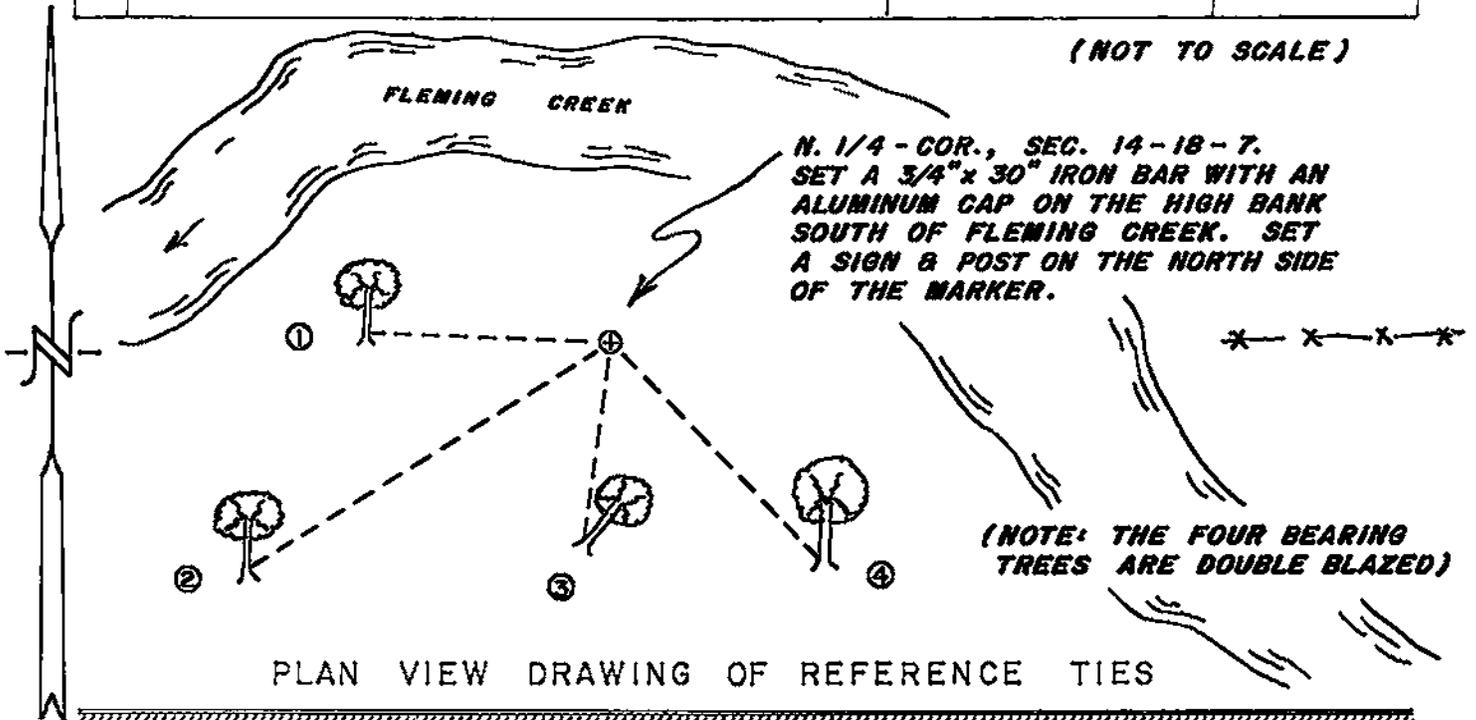


MAP SHOWING DISTANCE AND DIRECTION TO OTHER PUBLIC LAND SURVEY CORNERS USED FOR REESTABLISHING THE CORNER

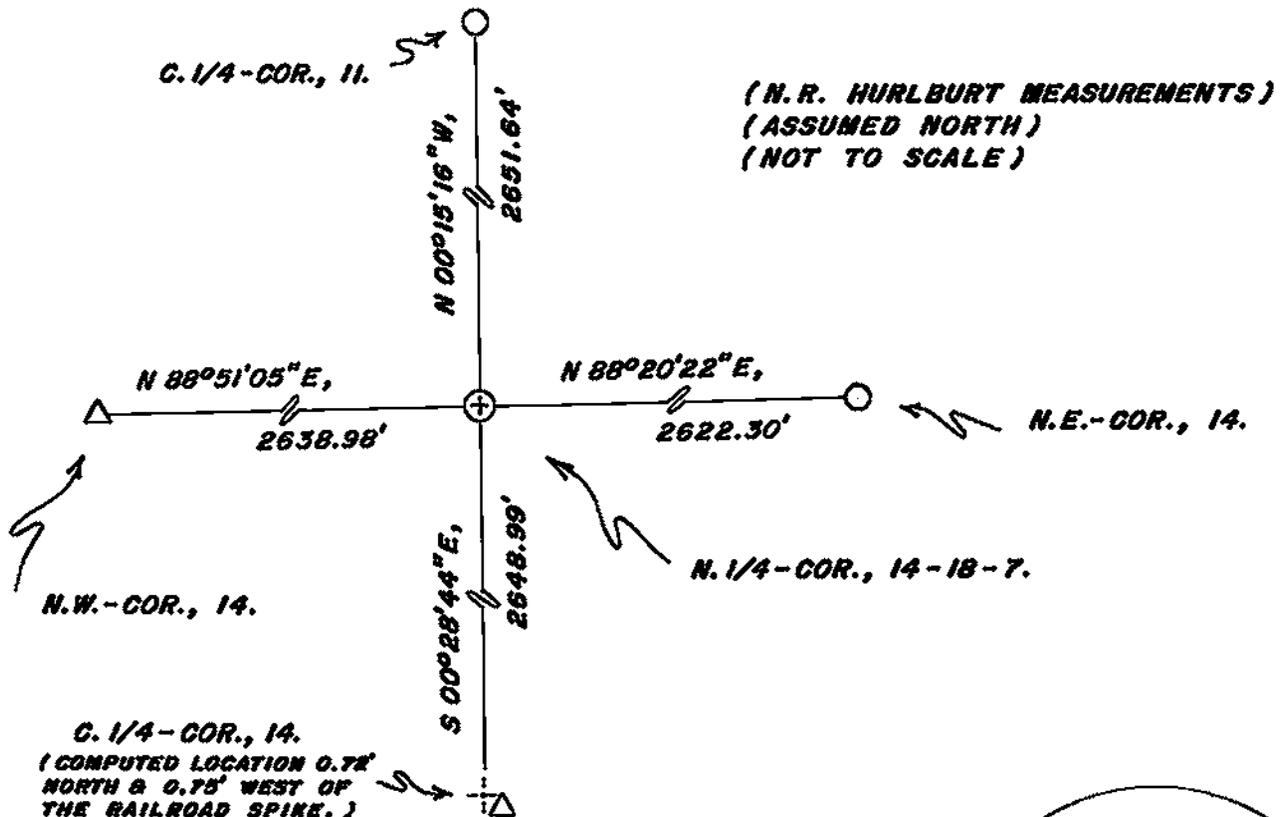

I, WILLIAM C. JUNG, COUNTY SURVEYOR  
HEREBY CERTIFY THAT THE CORNER LOCATION SHOWN ON THIS RECORD WAS DETERMINED BY ME OR UNDER MY DIRECTION AND CONTROL AND THAT THIS U. S. PUBLIC LAND SURVEY MONUMENT RECORD IS CORRECT AND COMPLETE TO THE BEST OF MY KNOWLEDGE AND BELIEF.

William C. Jung  
Signature

1/16/03  
Date

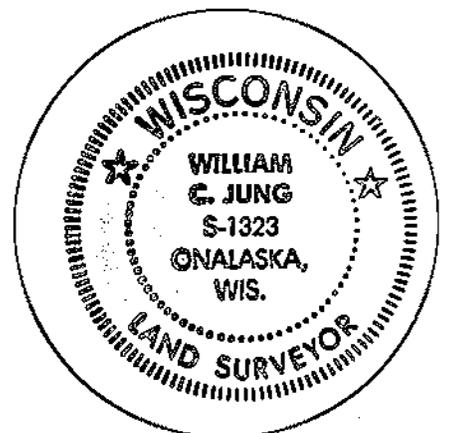

Seal