


21807130020

U. S. PUBLIC LAND SURVEY MONUMENT RECORD

SECTION 13 T 18 N, R 7 W, TOWN OF FARMINGTON
 LA CROSSE COUNTY

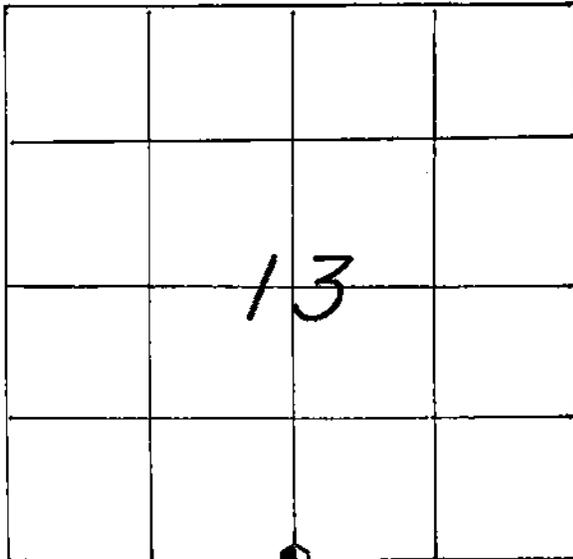

LOCATION OF LANDMARK

CREW: WILLIAM C. JUNG
 PETER F. FOLLANSBEE
 DATE: 11/02/1998

WISCONSIN COORDINATE SYSTEM
North
East
Theta Angle
Horiz. Order
Vert. Order
TYPE OF LANDMARK
BRASS CAP LUNDE MARKER.
BEARINGS ARE REFERENCED TO
ASSUMED NORTH.

Describe any record evidence, monument evidence, testimonial evidence or any other material evidence you considered and whether the monument was found or restored through acceptance of an obliterated evidence location.

I found what I believe to be the remains of an old original bearing tree to the Northeast. I monumented the corner with a brass capped Lunde marker. This location fits the South line of the section very well. This corner was set using the original bearing tree call.


Describe or show any material discrepancy between the location of the restored corner and that of the corner previously restored or reestablished.

None known.

RECORD OF DURABLE WITNESS MONUMENTS


MAGNETIC

NO	DESCRIPTION	BEARING	DISTANCE
1	SET A NAIL IN THE S.W.-SIDE OF A 5" ELM	N 41° W	29.93 FT.
2	SET A NAIL IN THE N.W.-SIDE OF AN 11" HICKORY	N 37° E	SL. = 42.89'
3	SET A NAIL IN THE S.-SIDE OF A 19" ASPEN	S 61° E	SL. = 12.07'
4	SET A NAIL IN THE N.E.-SIDE OF A 9" ELM	S 10° E	7.15 FT.

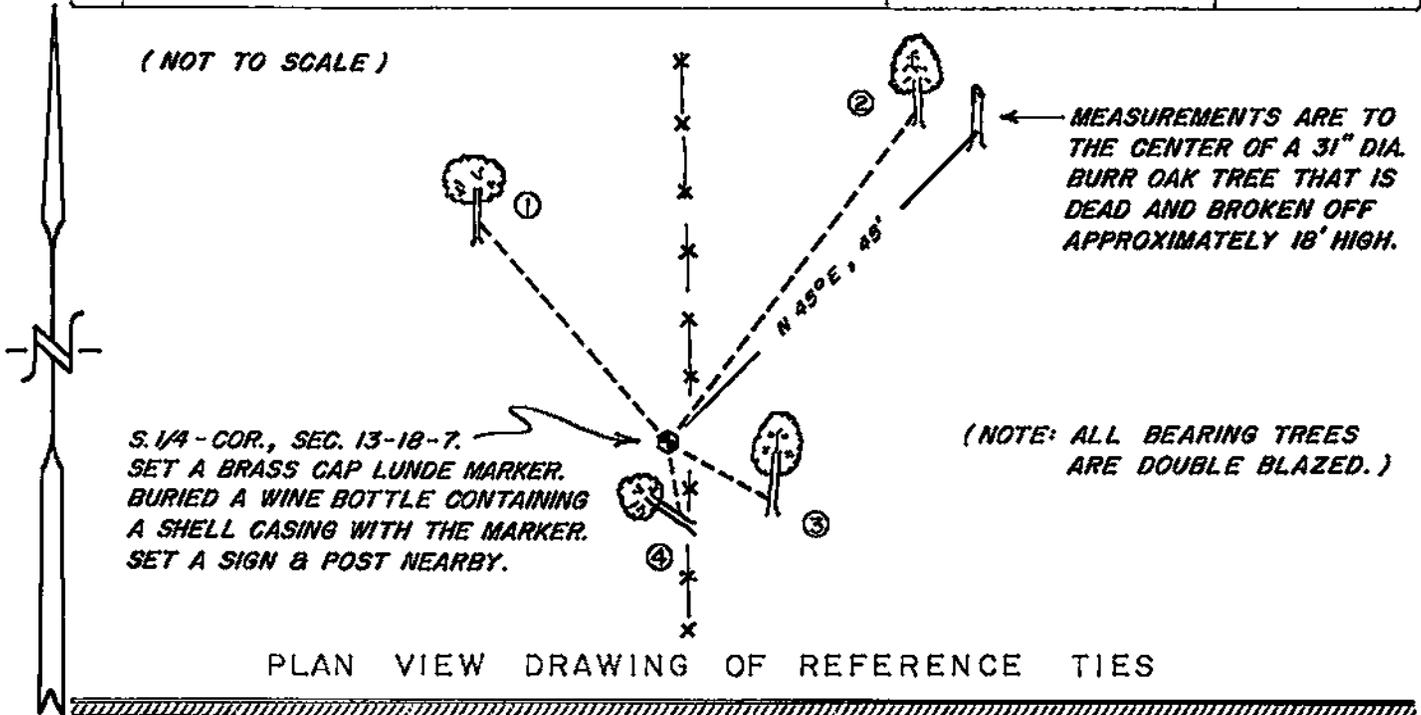

MAP SHOWING DISTANCE AND DIRECTION TO OTHER PUBLIC LAND SURVEY CORNERS USED FOR REESTABLISHING THE CORNER


(not to scale)

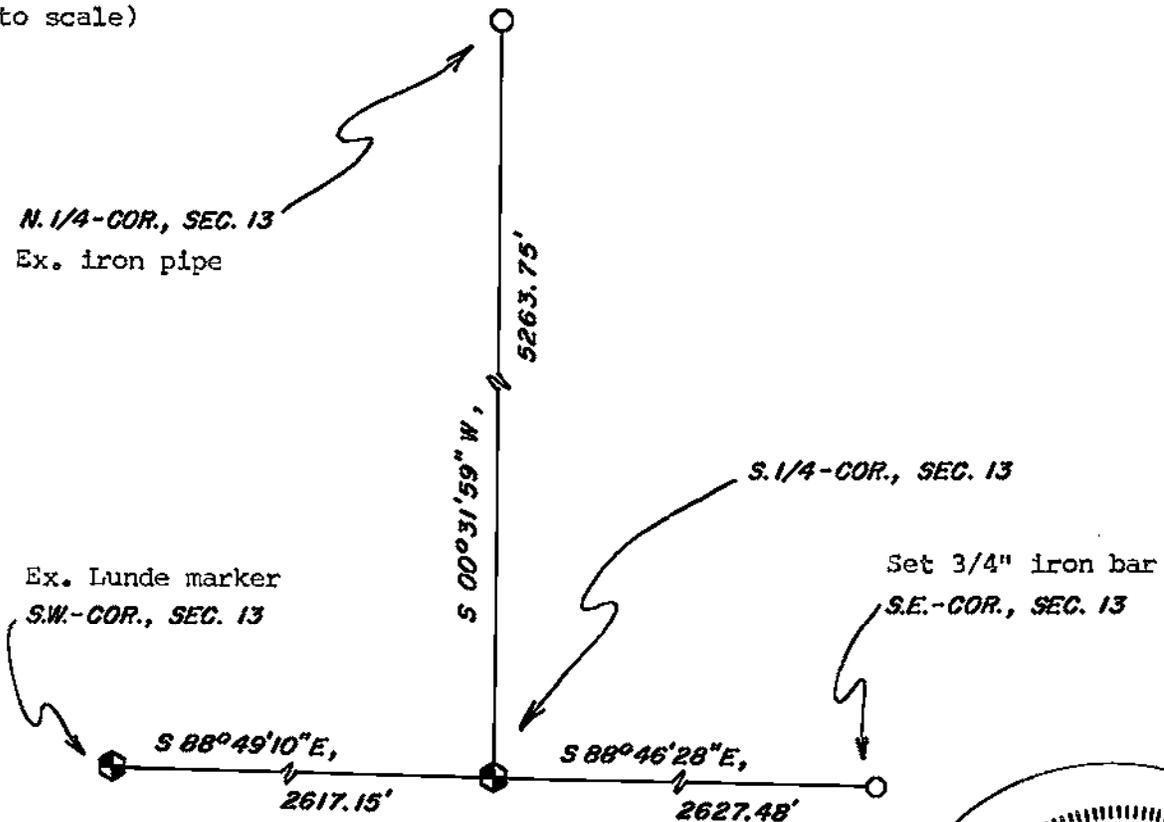

I, WILLIAM C. JUNG, COUNTY SURVEYOR
 HEREBY CERTIFY THAT THE CORNER LOCATION SHOWN ON THIS RECORD WAS DETERMINED BY ME OR UNDER MY DIRECTION AND CONTROL AND THAT THIS U. S. PUBLIC LAND SURVEY MONUMENT RECORD IS CORRECT AND COMPLETE TO THE BEST OF MY KNOWLEDGE AND BELIEF.

William C. Jung
 Signature

12/23/98
 Date

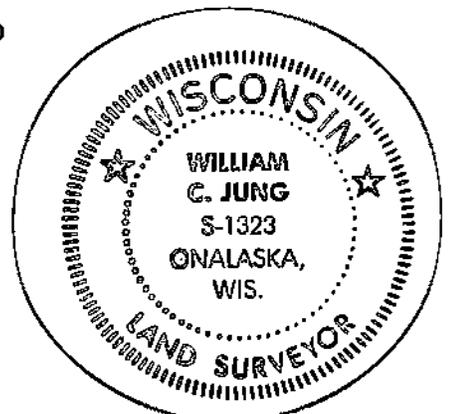

Seal