


21807140000

U. S. PUBLIC LAND SURVEY MONUMENT RECORD

SECTION 23 T 18 N, R 7 W, TOWN OF Farmington

LA CROSSE COUNTY

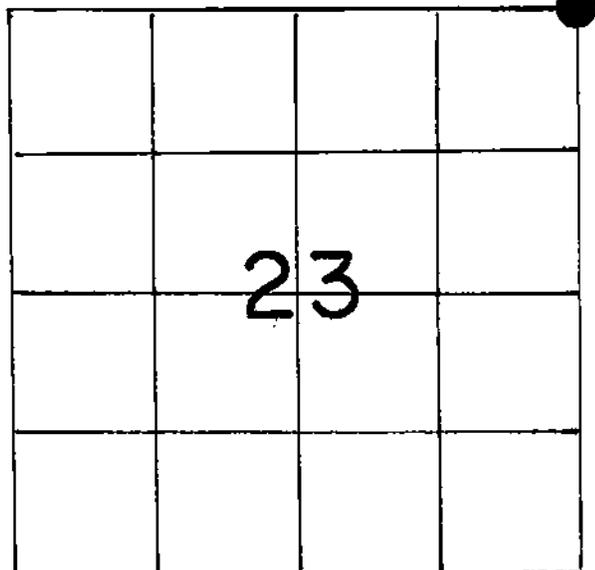

LOCATION OF LANDMARK

Crew: William C. Jung
Dan Leis

Date: 11/3/88

Describe any record evidence, monument evidence, testimonial evidence or any other material evidence you considered and whether the monument was found or restored through acceptance of an obliterated evidence location.

I found an iron pipe at the occupied fence corner that had been used as the corner in several previous surveys. I accepted this point as the best available evidence of the original government corner position. I removed the iron pipe and replaced it with a brass capped Lunde marker. I also set a steel fence post 0.3' to the Northwest of the corner and also as a memorial buried a liquor bottle with an empty M-16 cartridge to the Southeast of the marker.

Describe or show any material discrepancy between the location of the restored corner and that of the corner previously restored or reestablished.

None known.

WISCONSIN COORDINATE SYSTEM

North

East

Theta Angle

Horiz. Order

Vert. Order

TYPE OF LANDMARK

Brass capped Lunde marker


BEARINGS ARE REFERENCED TO

Assumed

RECORD OF DURABLE WITNESS MONUMENTS


NO	DESCRIPTION	BEARING	DISTANCE
1	Set a 8" spike in a 7" bearing tree	South \pm	48.20
2	Found a P.K. nail in the road centerline and 33' East of fence post with line fence to W.	NO-37-22E	2640.78
3	Set a 1 1/2" iron pipe	East \pm	32.97
4			

(not to scale)

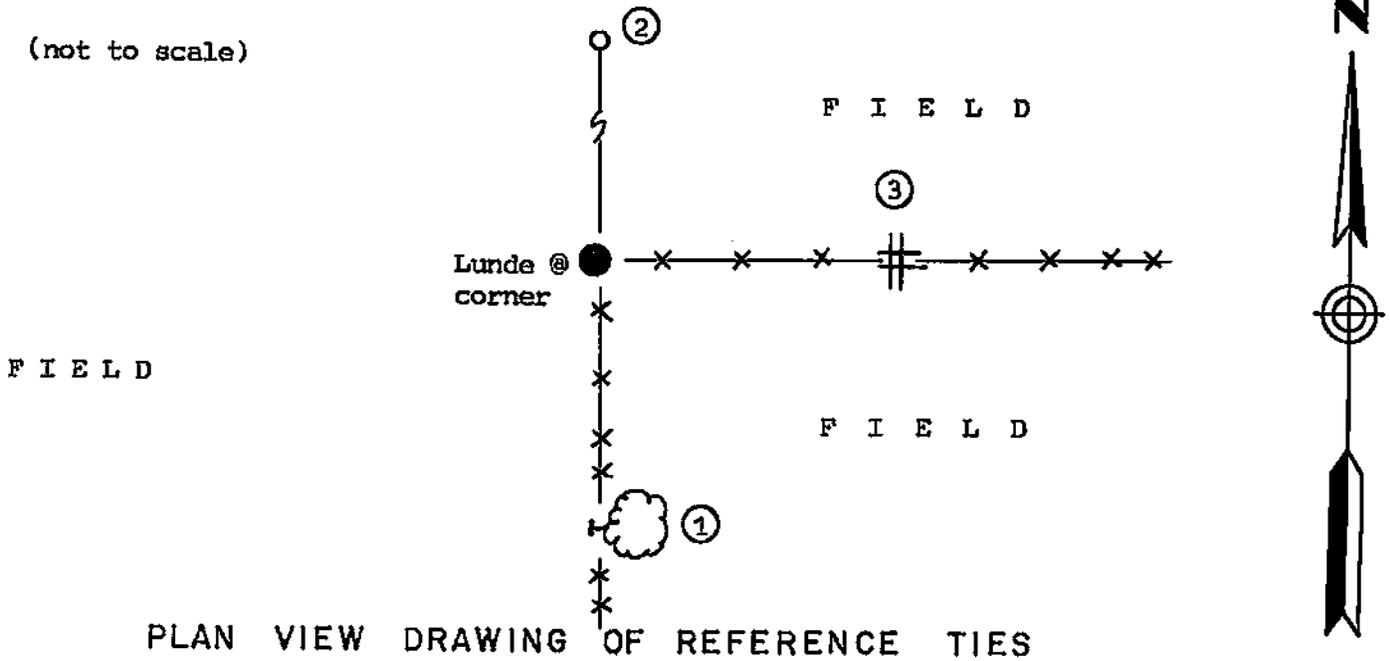

MAP SHOWING DISTANCE AND DIRECTION TO OTHER PUBLIC LAND SURVEY CORNERS USED FOR REESTABLISHING THE CORNER


(not to scale)

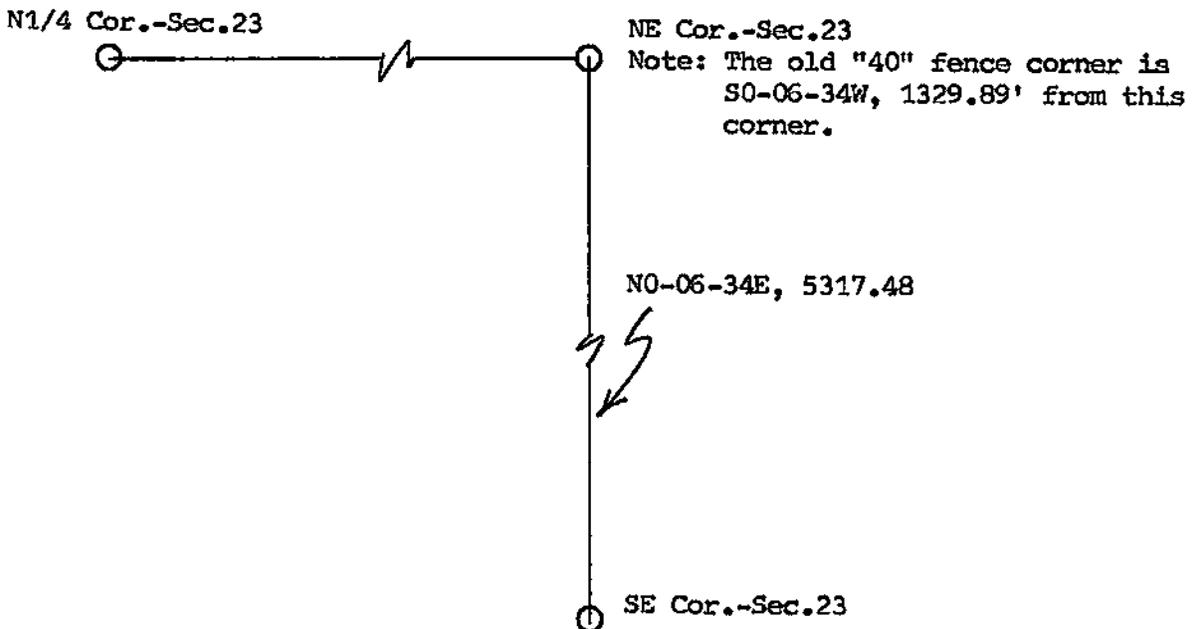

I, William C. Jung, Deputy County Surveyor.
 HEREBY CERTIFY THAT THE CORNER LOCATION SHOWN ON THIS RECORD
 WAS DETERMINED BY ME OR UNDER MY DIRECTION AND CONTROL AND
 THAT THIS U. S. PUBLIC LAND SURVEY MONUMENT RECORD IS CORRECT
 AND COMPLETE TO THE BEST OF MY KNOWLEDGE AND BELIEF.

William C. Jung
 Signature

1/24/89
 Date

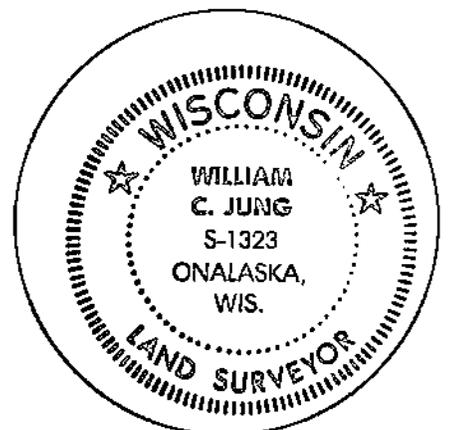

Seal