


21807140020

U. S. PUBLIC LAND SURVEY MONUMENT RECORD

SECTION 23 T 18 N, R 7 W, TOWN OF Farmington

LA CROSSE COUNTY

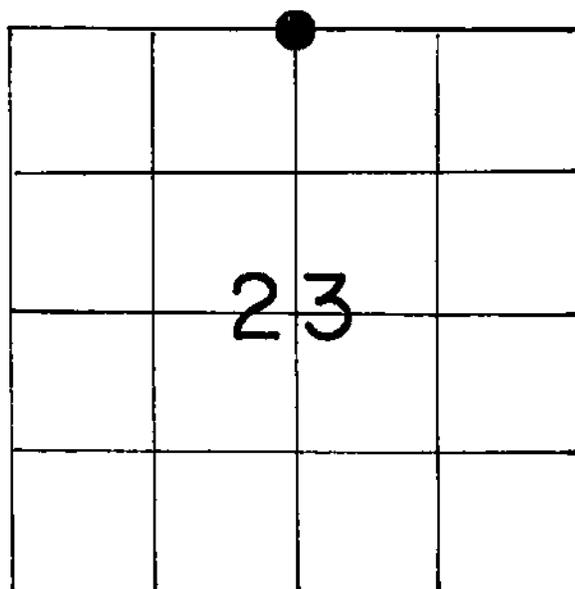

LOCATION OF LANDMARK

Crew: William C. Jung
Peter Follansbee

Date: 11/1/88

Describe any record evidence, monument evidence, testimonial evidence or any other material evidence you considered and whether the monument was found or restored through acceptance of an obliterated evidence location.

I accepted the old four way occupied fence corner as the best available evidence of the original government corner position and monumented it with a brass capped Lunde marker. As a memorial, I also buried a whiskey bottle with a blank bullet on the West side of the marker.

Describe or show any material discrepancy between the location of the restored corner and that of the corner previously restored or reestablished.

Dick Berg was at this corner in 1980. It would appear that he was 4' or so East of the fence corner. Scholze found a spike at this corner in 1984. I did not find any type of monument. I assume that the spike that Scholze found was possibly Berg's. I cannot agree with any corner that does not fit the actual fence corner. This fence corner was too old and substantial to disagree with.

WISCONSIN COORDINATE SYSTEM

North

East

Theta Angle

Horiz. Order

Vert. Order

TYPE OF LANDMARK

Brass capped Lunde marker


BEARINGS ARE REFERENCED TO

Assumed

RECORD OF DURABLE WITNESS MONUMENTS

NO	DESCRIPTION	BEARING	DISTANCE
1	P.K. nail in double blazed 5" hickory	-----	23.98
2	" " " " " 7" "	-----	19.58
3	" " " " " 8" "	-----	14.31
4	" " " " " 4" "	-----	11.63


(not to scale)

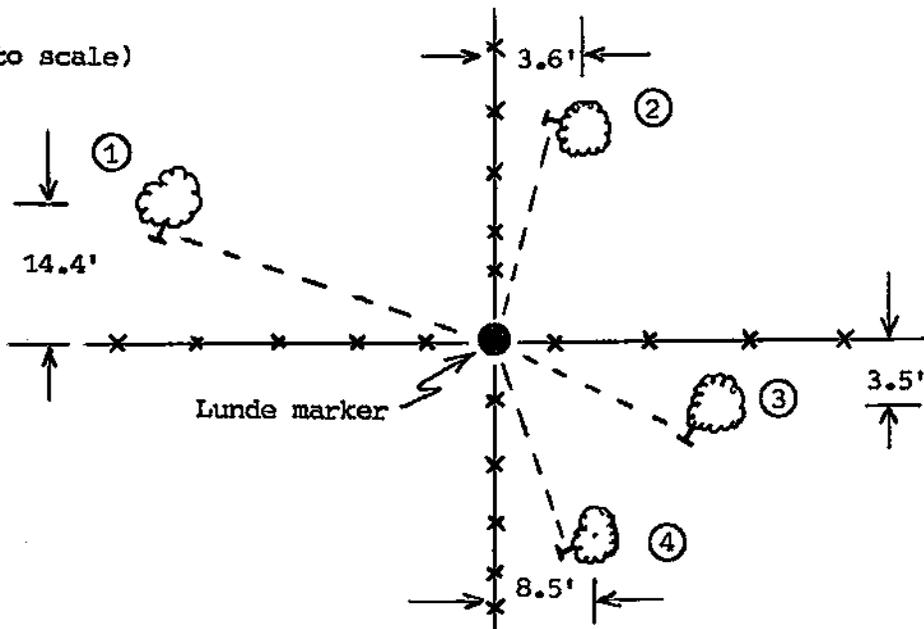

PLAN VIEW DRAWING OF REFERENCE TIES

MAP SHOWING DISTANCE AND DIRECTION TO OTHER PUBLIC LAND SURVEY CORNERS USED FOR REESTABLISHING THE CORNER


(not to scale)

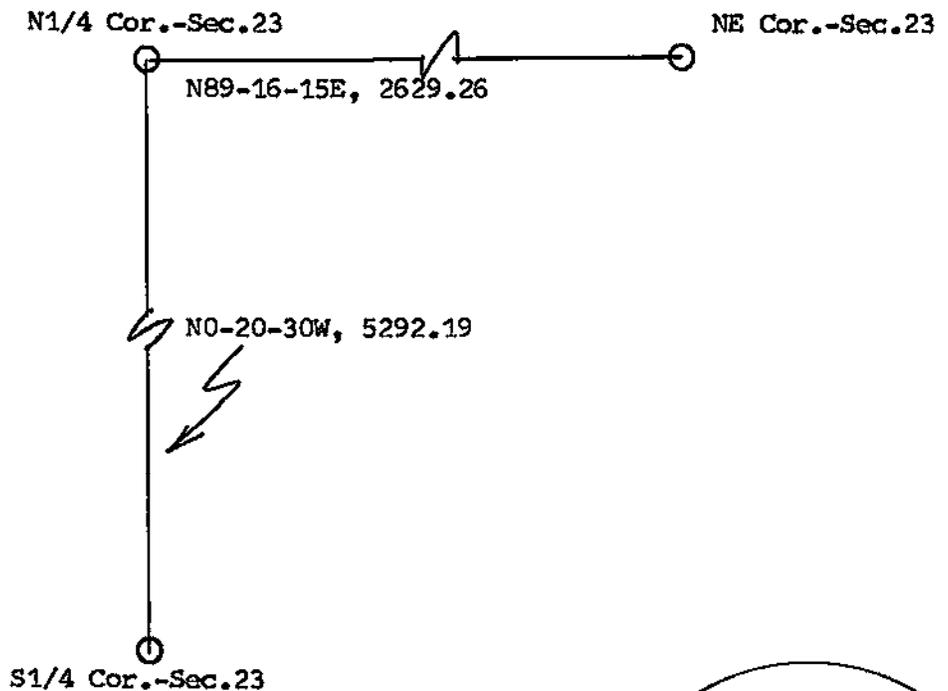

I, William C. Jung, Deputy County Surveyor,
 HEREBY CERTIFY THAT THE CORNER LOCATION SHOWN ON THIS RECORD
 WAS DETERMINED BY ME OR UNDER MY DIRECTION AND CONTROL AND
 THAT THIS U. S. PUBLIC LAND SURVEY MONUMENT RECORD IS CORRECT
 AND COMPLETE TO THE BEST OF MY KNOWLEDGE AND BELIEF.

William C. Jung
 Signature

1/23/89
 Date

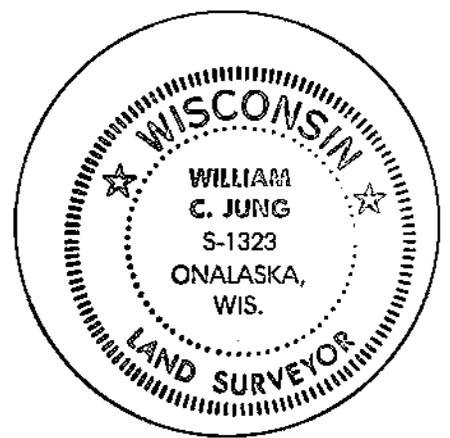

Seal