


21807150000

U. S. PUBLIC LAND SURVEY MONUMENT RECORD

SECTION 23 T 18 N, R 7 W, TOWN OF FARMINGTON

LA CROSSE COUNTY

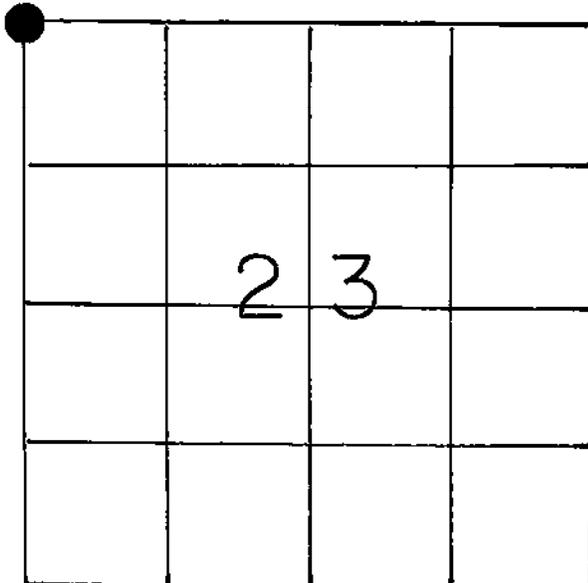

LOCATION OF LANDMARK

Crew: William C. Jung
Peter F. Follansbee

Date: May 15, 1992

Describe any record evidence, monument evidence, testimonial evidence or any other material evidence you considered and whether the monument was found or restored through acceptance of an obliterated evidence location.

I set the corner at Hurlburt's computed location which is also at the old occupied fence corner location. This location was accepted as the best available evidence of the original government corner position. A wine bottle was buried on the NE side of the Lunde. A post with sign was set to the East.

Describe or show any material discrepancy between the location of the restored corner and that of the corner previously restored or reestablished.

None known.

WISCONSIN COORDINATE SYSTEM

North

East

Theta Angle

Horiz. Order

Vert. Order


TYPE OF LANDMARK

Brass capped Lunde marker

BEARINGS ARE REFERENCED TO

RECORD OF DURABLE WITNESS MONUMENTS

NO	DESCRIPTION	BEARING	DISTANCE
1	Set 1 1/4"x25" iron pipe	-----	14.46
2	P.K. nail in single blazed double box elder	-----	15.10
3	Set 1 1/4"x29" iron pipe	-----	15.52
4	P.K. nail in single blazed 7" box elder	-----	25.41

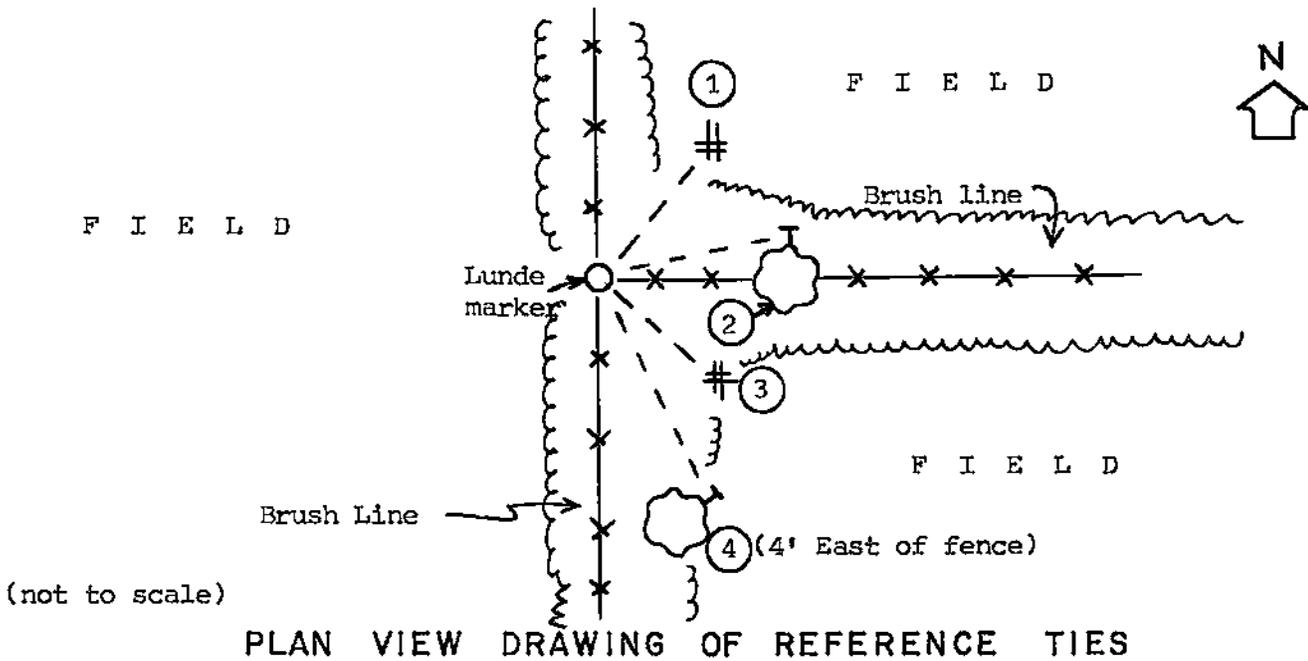


MAP SHOWING DISTANCE AND DIRECTION TO OTHER PUBLIC LAND SURVEY CORNERS USED FOR REESTABLISHING THE CORNER

No section measurements made by me at this time. Corner location confirmed by Hurlburt section work.

I, William C. Jung, Deputy County Surveyor,
 HEREBY CERTIFY THAT THE CORNER LOCATION SHOWN ON THIS RECORD
 WAS DETERMINED BY ME OR UNDER MY DIRECTION AND CONTROL AND
 THAT THIS U. S. PUBLIC LAND SURVEY MONUMENT RECORD IS CORRECT
 AND COMPLETE TO THE BEST OF MY KNOWLEDGE AND BELIEF.

William C. Jung May 26, 1992
 Signature Date

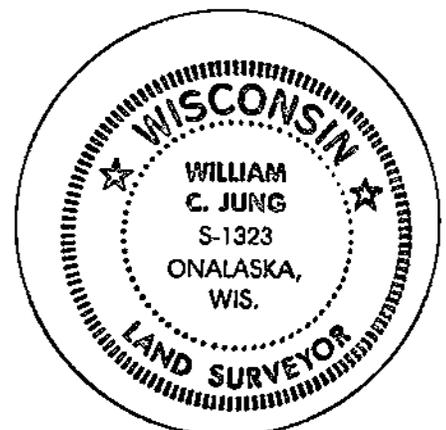

Seal