


21807152000

U. S. PUBLIC LAND SURVEY MONUMENT RECORD

SECTION 15 T 18 N, R 7 W, TOWN OF FARMINGTON
 LA CROSSE COUNTY

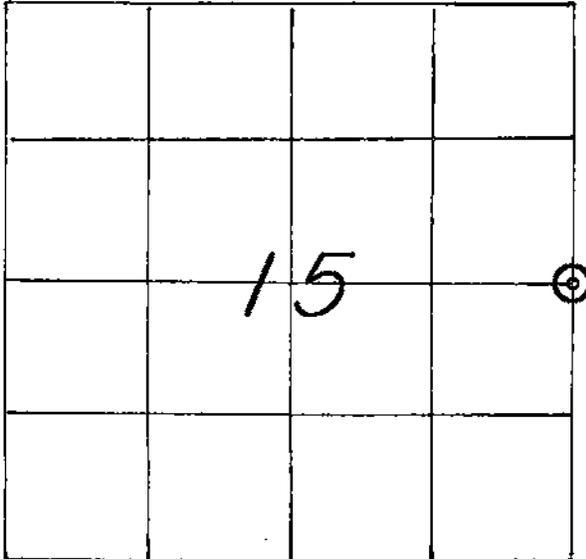

WISCONSIN COORDINATE SYSTEM

North

East

Theta Angle

Horiz. Order

Vert. Order

TYPE OF LANDMARK

3/4" x 30" ROUND IRON BAR W/ALUMINUM CAP.

BEARINGS ARE REFERENCED TO

LOCATION OF LANDMARK

CREW: WILLIAM C. JUNG
 PETER F. FOLLANSBEE
 DATE: 12/18/1997

Describe any record evidence, monument evidence, testimonial evidence or any other material evidence you considered and whether the monument was found or restored through acceptance of an obliterated evidence location.


I set an iron bar at Hurlburt's calculated corner position. Maxwell has agreed that his pipe 1.94' to the SE is not correct. The iron bar is at a single proportionate position.

Describe or show any material discrepancy between the location of the restored corner and that of the corner previously restored or reestablished.

NONE KNOWN.

RECORD OF DURABLE WITNESS MONUMENTS

NO	DESCRIPTION	BEARING	DISTANCE
1	SET A NAIL IN THE E-SIDE 8" ELM (DOUBLE BLAZED)	S 03° W (MAG.)	63.25 FT.
2	EXISTING RAILROAD SPIKE NORTH OF PAVEMENT	S'WESTERLY ±	SLOPE = 32.48'
3	EXISTING 1" IRON PIPE (O.D.) (R. MAXWELL'S PIPE)	S'EASTERLY ±	1.94 FT.
4	EXISTING RAILROAD SPIKE NORTH OF PAVEMENT	S'EASTERLY ±	SLOPE = 33.55'

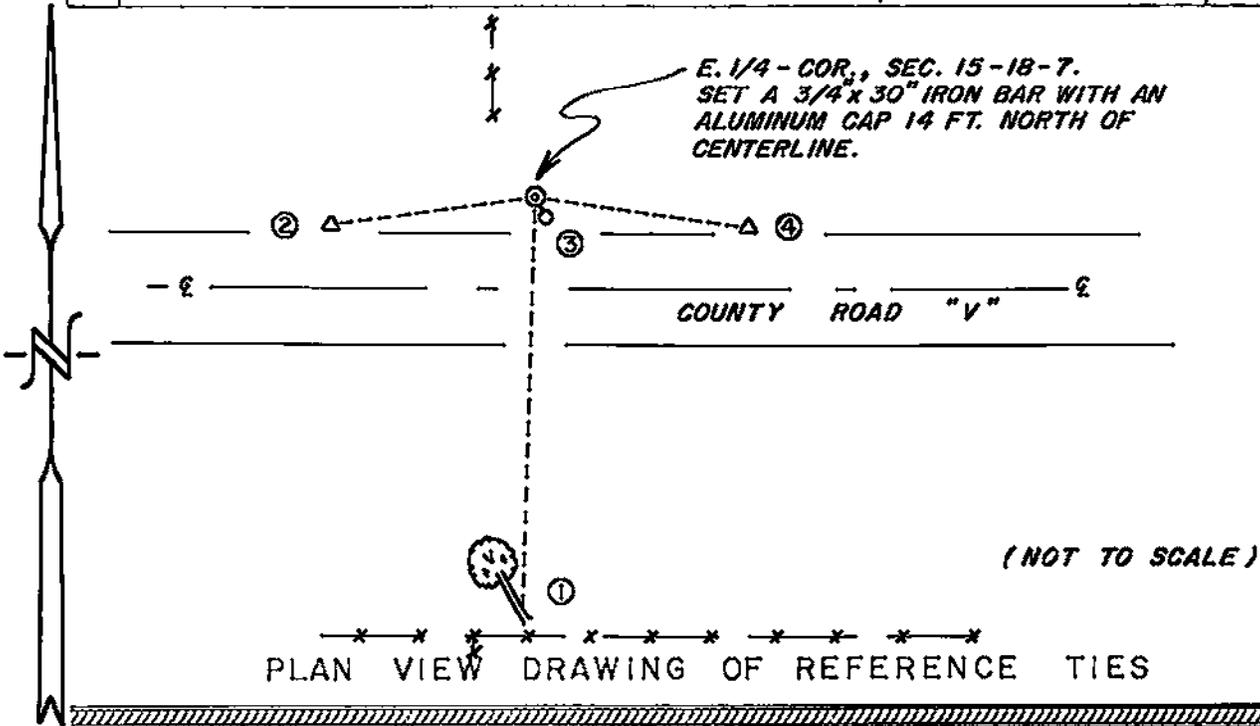

MAP SHOWING DISTANCE AND DIRECTION TO OTHER PUBLIC LAND SURVEY CORNERS USED FOR REESTABLISHING THE CORNER

No section measurements were made by me at this time. Hurlburt confirmed this location through his section work.

I, WILLIAM C. JUNG, COUNTY SURVEYOR
HEREBY CERTIFY THAT THE CORNER LOCATION SHOWN ON THIS RECORD WAS DETERMINED BY ME OR UNDER MY DIRECTION AND CONTROL AND THAT THIS U. S. PUBLIC LAND SURVEY MONUMENT RECORD IS CORRECT AND COMPLETE TO THE BEST OF MY KNOWLEDGE AND BELIEF.

William C. Jung 1/13/98
Signature Date



Seal