


21807160000

U. S. PUBLIC LAND SURVEY MONUMENT RECORD

SECTION 22 T 18 N, R 7 W, TOWN OF Farmington  
 LA CROSSE COUNTY

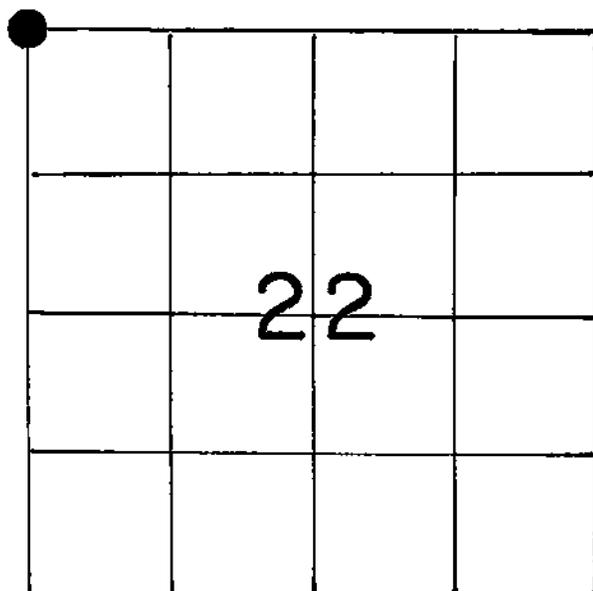

LOCATION OF LANDMARK

Crew: William C. Jung  
 Peter Follansbee

Date: 9/21/88

WISCONSIN COORDINATE SYSTEM
North
East
Theta Angle
Horiz. Order
Vert. Order
TYPE OF LANDMARK $1\frac{1}{4}$ "x40" iron pipe <del>Brass capped Lunde marker</del>
BEARINGS ARE REFERENCED TO

Crew: William C. Jung  
 Peter Follansbee

Date: 5/19/92

Describe any record evidence, monument evidence, testimonial evidence or any other material evidence you considered and whether the monument was found or restored through acceptance of an obliterated evidence location.

I found a 5/8" rebar at the road intersection. This point has been used as the corner in previous surveys. I accepted this location as the best available evidence of the original government corner position. I removed the rebar and replaced it with a brass capped Lunde marker, flush.


The Lunde marker was destroyed during the paving of C.T.H. "V". We reset the corner with an iron pipe. We also found an iron bar, down 1', 1.5' W-SW of the corner.

Describe or show any material discrepancy between the location of the restored corner and that of the corner previously restored or reestablished.

None known.

RECORD OF DURABLE WITNESS MONUMENTS

NO	DESCRIPTION	BEARING	DISTANCE	
1	Set 1" iron pipe	-----	<del>35.82</del>	35.83
2	Set 1" iron pipe on road bank	-----	<del>33.47</del>	33.46
3	To an iron pipe set on the Southeast side of a <del>To P.K. nail in double-blazed 10" double poplar</del> stump	-----	<del>43.44</del>	43.52
4	To the center of the base of a telephone box	-----	<del>38.65</del>	38.52

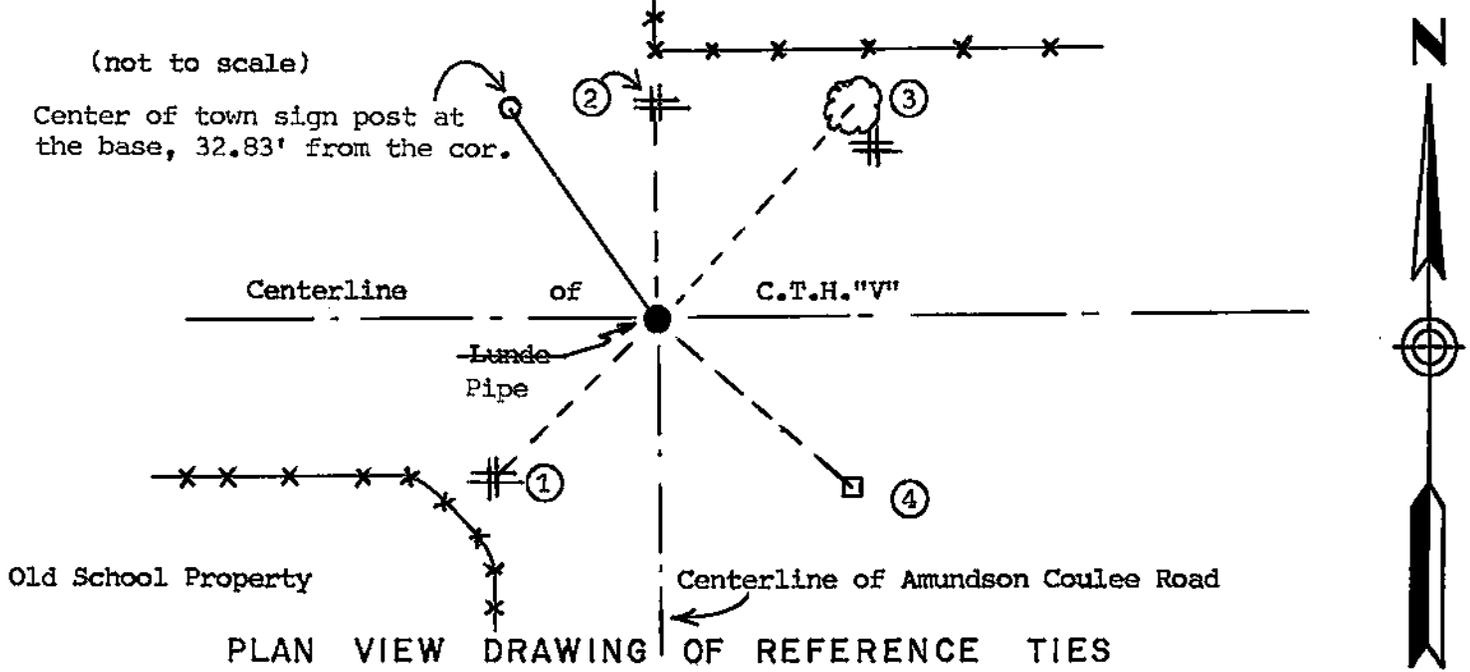

MAP SHOWING DISTANCE AND DIRECTION TO OTHER PUBLIC LAND SURVEY CORNERS USED FOR REESTABLISHING THE CORNER


(No section measurements were made by me at this time. The West line of Section 22 was measured by Norm Hurlburt.)

I, William C. Jung, Deputy County Surveyor,  
 HEREBY CERTIFY THAT THE CORNER LOCATION SHOWN ON THIS RECORD  
 WAS DETERMINED BY ME OR UNDER MY DIRECTION AND CONTROL AND  
 THAT THIS U. S. PUBLIC LAND SURVEY MONUMENT RECORD IS CORRECT  
 AND COMPLETE TO THE BEST OF MY KNOWLEDGE AND BELIEF.

William C. Jung  
 Signature

1/19/89  
 Date

Revised: 6/3/92

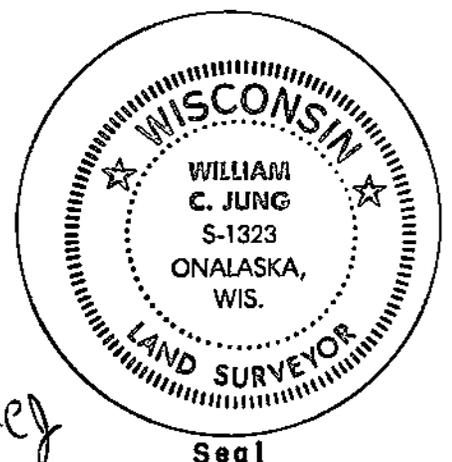

Seal

*wcj*