


21807162000

U. S. PUBLIC LAND SURVEY MONUMENT RECORD

SECTION 15 T 18 N, R 7 W, TOWN OF FARMINGTON

LA CROSSE COUNTY

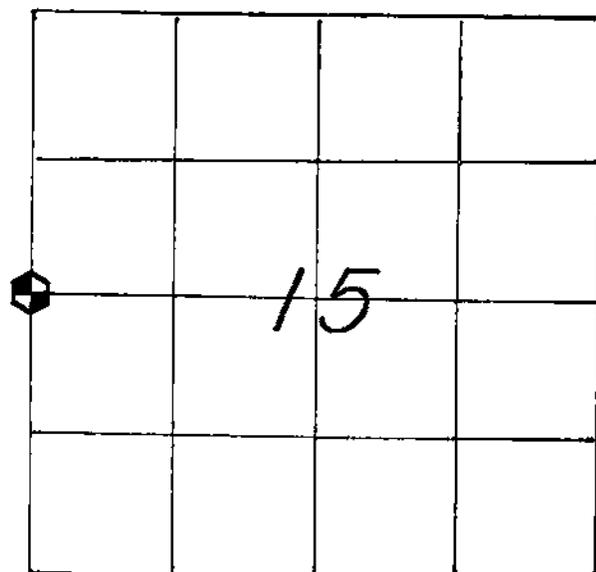

WISCONSIN COORDINATE SYSTEM

North

East

Theta Angle

Horiz. Order

Vert. Order

TYPE OF LANDMARK

BRASS CAP LUNDE MARKER.

BEARINGS ARE REFERENCED TO

LOCATION OF LANDMARK

CREW: WILLIAM C. JUNG
 RON (PARAGON ASSOCIATES)
 PETER F. FOLLANSBEE
 DATE: 8/26/1997

Describe any record evidence, monument evidence, testimonial evidence or any other material evidence you considered and whether the monument was found or restored through acceptance of an obliterated evidence location.


While surveying in Section 15, Paul Fairchild's survey crew found what they believed to be an original bearing tree Northwest of this corner. After going to the corner with Ron, I inspected the white oak in question and agreed that it was in all probability the tree called for. I set the corner off this tree and monumented it with a brass capped Lunde marker.

Describe or show any material discrepancy between the location of the restored corner and that of the corner previously restored or reestablished.

NONE KNOWN.

RECORD OF DURABLE WITNESS MONUMENTS
MAGNETIC

NO	DESCRIPTION	BEARING	DISTANCE
1	SET A RK.NAIL IN S.W.-SIDE 40" WHITE OAK(UNBLAZED)	N 64° W	53.73 FT.
2	SET A NAIL IN S.W.-SIDE 15" WHITE OAK(DOUBLE BLAZED)	N 51° W	24.72 FT.
3	SET A NAIL IN S.W.-SIDE 21" WHITE OAK(DOUBLE BLAZED)	S 80° E	46.20 FT.
4	SET A NAIL IN S.W.-SIDE 13-1/2" WHITE OAK(DOUBLE BLAZED)	S 49° E	23.72 FT.

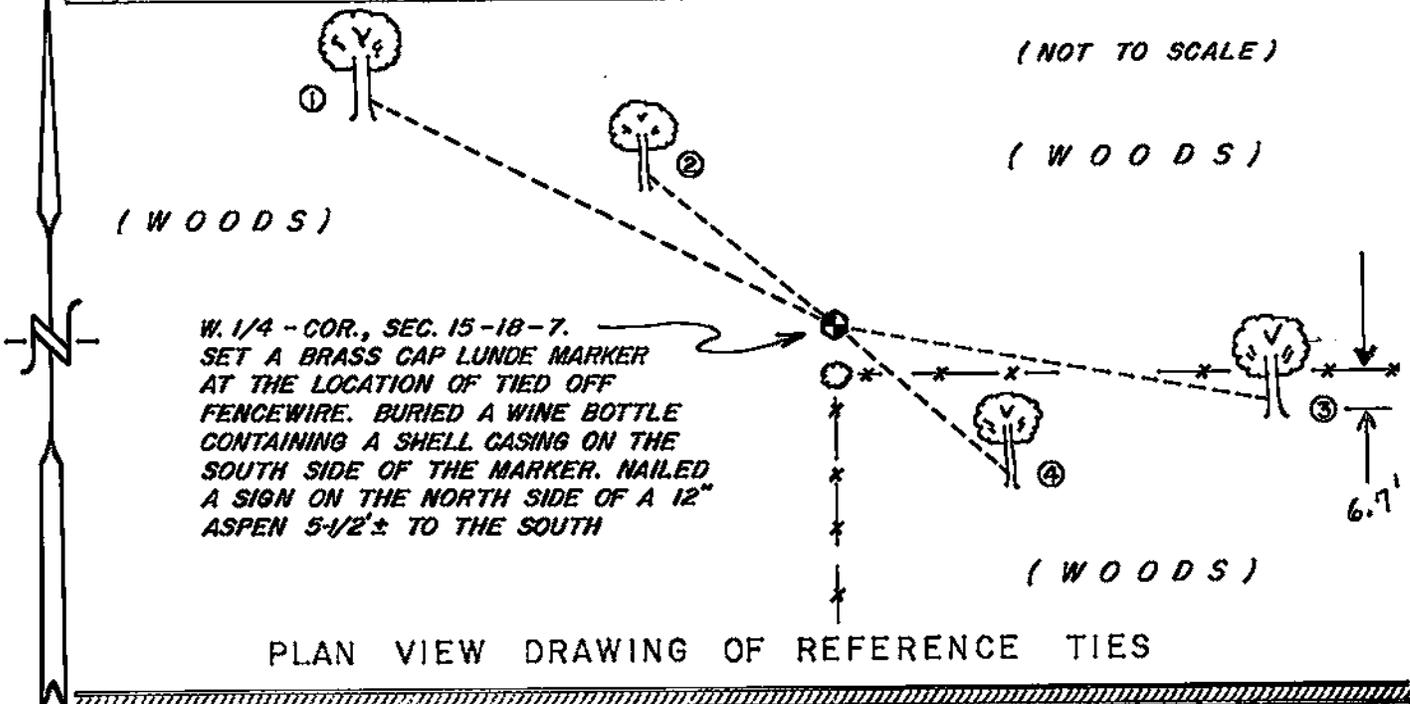

MAP SHOWING DISTANCE AND DIRECTION TO OTHER PUBLIC LAND SURVEY CORNERS USED FOR REESTABLISHING THE CORNER

No section measurements were made by me at this time. Paul Fairchild confirmed the location of this corner with his section work.

I, WILLIAM C. JUNG, COUNTY SURVEYOR
HEREBY CERTIFY THAT THE CORNER LOCATION SHOWN ON THIS RECORD
WAS DETERMINED BY ME OR UNDER MY DIRECTION AND CONTROL AND
THAT THIS U. S. PUBLIC LAND SURVEY MONUMENT RECORD IS CORRECT
AND COMPLETE TO THE BEST OF MY KNOWLEDGE AND BELIEF.

William C. Jung 1/12/98
Signature Date



Seal