


21807170020

U. S. PUBLIC LAND SURVEY MONUMENT RECORD

SECTION 17 T 18 N, R 7 W, TOWN OF HOLLAND

LA CROSSE COUNTY

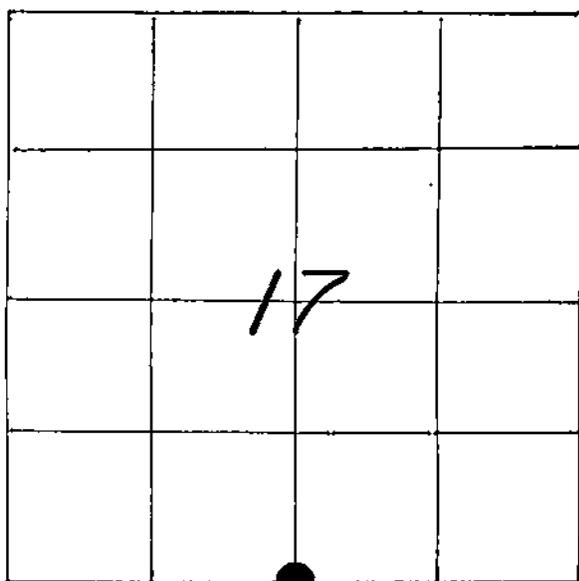

LOCATION OF LANDMARK

CREW: WILLIAM G. JUNG
 PETER F. FOLLANSBEE
 DATE: 8/05/1999

WISCONSIN COORDINATE SYSTEM

North

East

Theta Angle

Horiz. Order

Vert. Order

TYPE OF LANDMARK

EXISTING 3/4" IRON BAR.

BEARINGS ARE REFERENCED TO

Describe any record evidence, monument evidence, testimonial evidence or any other material evidence you considered and whether the monument was found or restored through acceptance of an obliterated evidence location.

I found an iron bar at the old fence corner. This had been used in previous survey work by others. The location also fits the old 1956 highway survey. I accepted this old occupied location as the best available evidence of the original government corner position.


Describe or show any material discrepancy between the location of the restored corner and that of the corner previously restored or reestablished.

NONE KNOWN.

RECORD OF DURABLE WITNESS MONUMENTS

MAGNETIC

NO	DESCRIPTION	BEARING	DISTANCE
1	SET A P.K. NAIL IN SE-SIDE 14" HICKORY	S 71° W	39.55 FT.
2	SET A P.K. NAIL IN S-SIDE 11" TRIPLE OAK	N 72° W	24.70 FT.
3	SET A NAIL IN S.W.-SIDE 4-1/2" DOUBLE OAK	S 45° E ±	SL. = 18.90'
4	SET A NAIL IN N.E.-SIDE 4-1/2" OAK	S 25° E ±	25.21 FT.

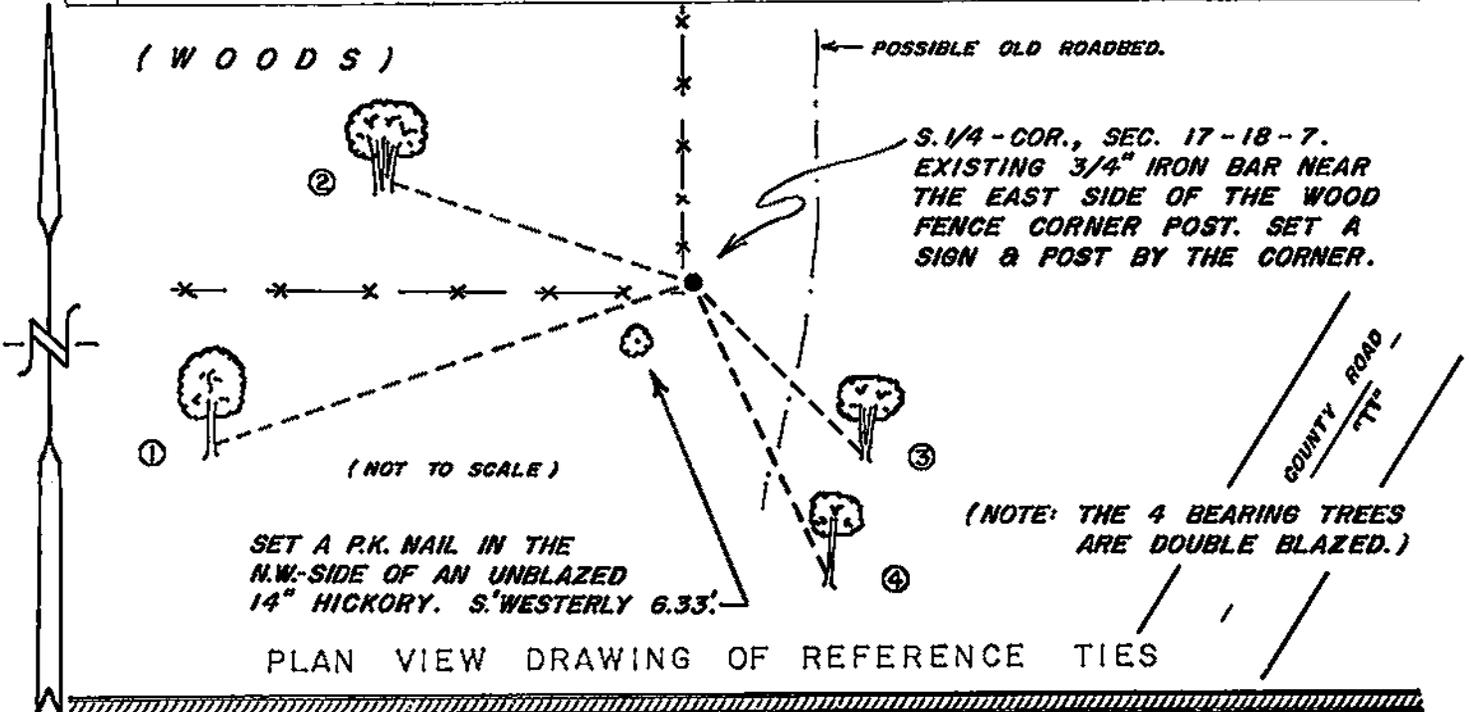

MAP SHOWING DISTANCE AND DIRECTION TO OTHER PUBLIC LAND SURVEY CORNERS USED FOR REESTABLISHING THE CORNER

No section measurements were made by me at this time. The location of this corner was confirmed by others.

I, WILLIAM C. JUNG, COUNTY SURVEYOR
HEREBY CERTIFY THAT THE CORNER LOCATION SHOWN ON THIS RECORD
WAS DETERMINED BY ME OR UNDER MY DIRECTION AND CONTROL AND
THAT THIS U. S. PUBLIC LAND SURVEY MONUMENT RECORD IS CORRECT
AND COMPLETE TO THE BEST OF MY KNOWLEDGE AND BELIEF.

William C. Jung
Signature

September 15, 1999
Date

