


## U. S. PUBLIC LAND SURVEY MONUMENT RECORD

SECTION 18 T 18 N, R 7 W, TOWN OF HOLLAND

LA CROSSE COUNTY

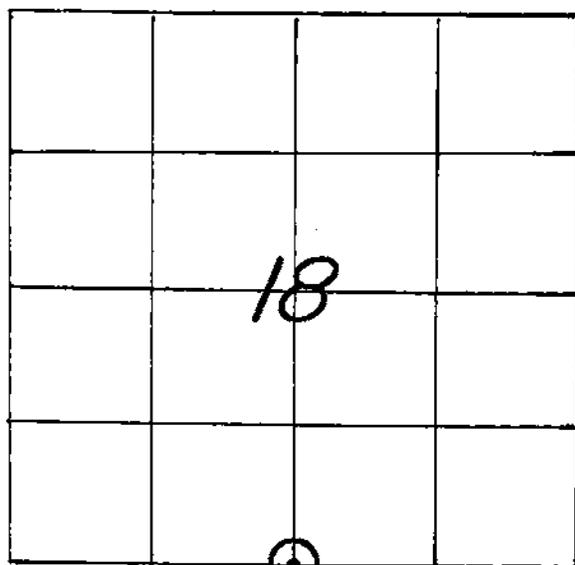

LOCATION OF LANDMARK

CREW: WILLIAM G. JUNG  
 PETER F. FOLLANSBEE  
 DATE: 12/13/2007

WISCONSIN COORDINATE SYSTEM	
North	741,572.481
East	1,636,801.862
Theta Angle	
Horiz. Order	
Vert. Order	
DATUM:	1983('91)
TYPE OF LANDMARK	
3/4" x 24" REBAR WITH RED PLASTIC CAP.	
BEARINGS ARE REFERENCED TO	
GRID NORTH AS PER SECTION DATA.	

Describe any record evidence, monument evidence, testimonial evidence or any other material evidence you considered and whether the monument was found or restored through acceptance of an obliterated evidence location.


I set this corner by single proportionate measurement. The corner falls about 11 feet north of the old east-west fence. After inspecting this fence and measuring into it from Holseth Road to the east, I don't think that this fence was built on the actual line.

Describe or show any material discrepancy between the location of the restored corner and that of the corner previously restored or reestablished.

With the work that Bob Chalsma did to the north back in 1984 and 1985, he would have needed this corner for his section split. I don't know what he did nor could we find a monument at this corner. We looked at great length, the first time being back in April of 2004. Surveys by Hengel in 1975 and Pederson in 1977 lead me to believe that they used fences that are not on the section line. The "section line" fences east and west of Holseth Road do not line up. Clayton Solberg had two surveys in 1979 and 1980 that used a bad fence. In 1994 Steve Solberg did a CSM which indicates a pipe at this corner "found by others". We did not find a pipe. Who the "others" are I can only guess. Solberg's "pipe" would fall about 20 feet north of my corner position. I found nothing up there.


RECORD OF DURABLE WITNESS MONUMENTS

NO	DESCRIPTION	MAGNETIC	
		BEARING	DISTANCE
1	SET A NAIL IN N.E.-SIDE OF AN 18" HICKORY	N 45° W	35.22 FT.
2	SET A NAIL IN S.-SIDE OF A 5 1/2" BASSWOOD	N 85° E	27.74 FT.
3	SET A NAIL IN N.E.-SIDE OF A 13" BASSWOOD	S 28° E	22.59 FT.
4	SET A NAIL IN S.E.-SIDE OF A 17" WHITE OAK	S 26° W	SLOPE = 54.75'

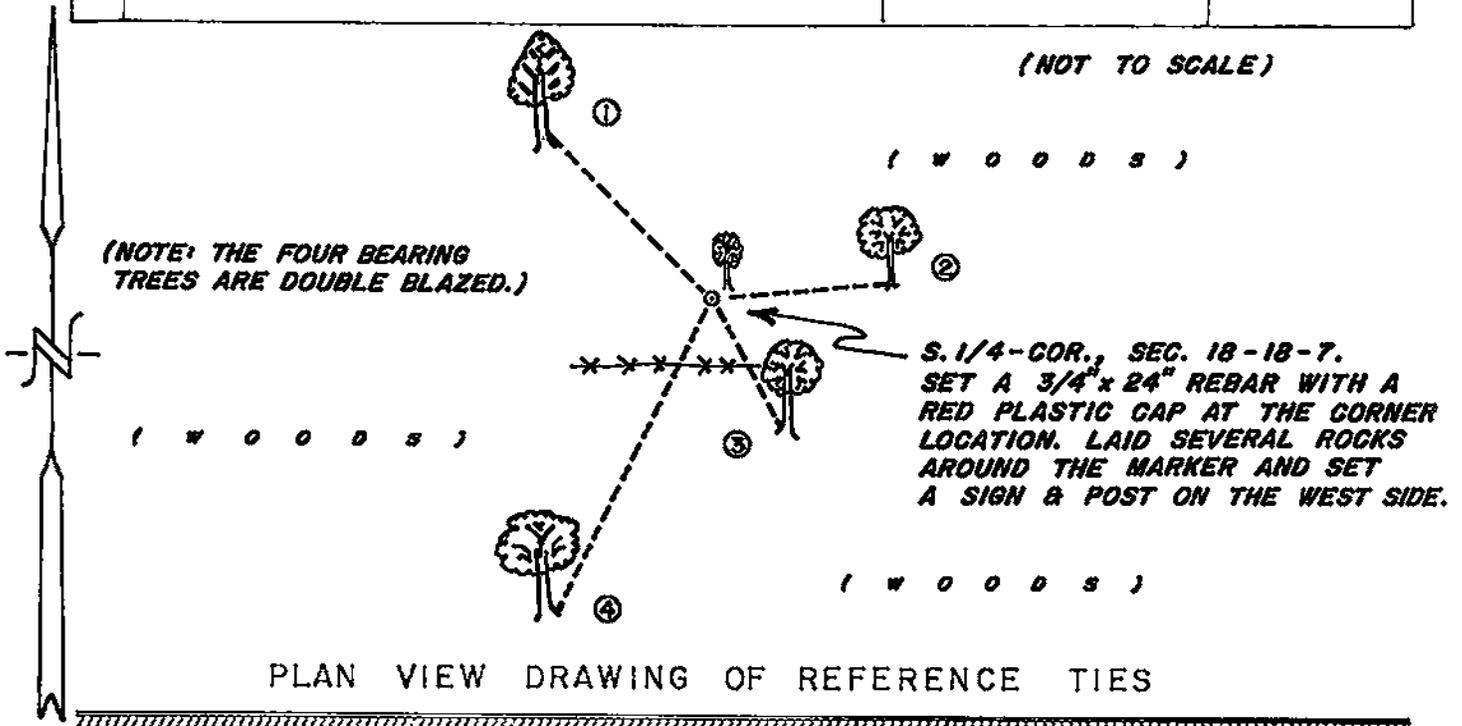

MAP SHOWING DISTANCE AND DIRECTION TO OTHER PUBLIC LAND SURVEY CORNERS USED FOR REESTABLISHING THE CORNER

(GRID BEARINGS AND DISTANCES)  
(GRID FACTOR: 0.99994)  
(NOT TO SCALE)

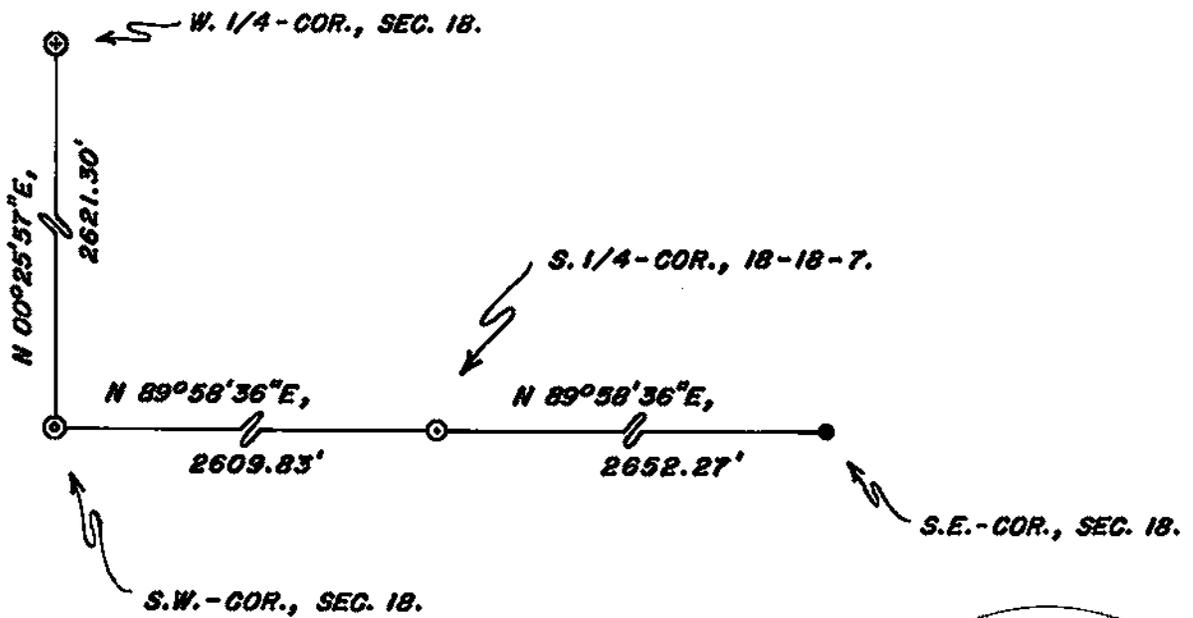

I, WILLIAM C. JUNG, COUNTY SURVEYOR  
HEREBY CERTIFY THAT THE CORNER LOCATION SHOWN ON THIS RECORD WAS DETERMINED BY ME OR UNDER MY DIRECTION AND CONTROL AND THAT THIS U. S. PUBLIC LAND SURVEY MONUMENT RECORD IS CORRECT AND COMPLETE TO THE BEST OF MY KNOWLEDGE AND BELIEF.

William C. Jung                      12/21/07  
Signature                                      Date



Seal