


21807182000

U. S. PUBLIC LAND SURVEY MONUMENT RECORD

SECTION 18 T 18 N, R 7 W, TOWN OF HOLLAND

LA CROSSE COUNTY

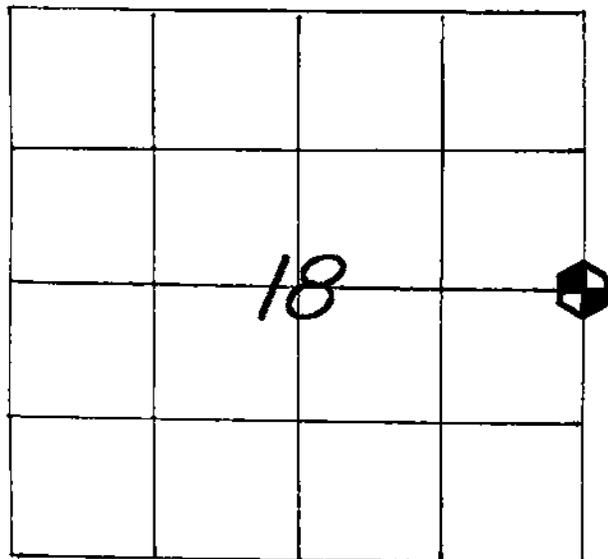

LOCATION OF LANDMARK

CREW: **WILLIAM G. JUNG**
PETER F. FOLLANSBEE
 DATE: **9/21/2007**


WISCONSIN COORDINATE SYSTEM	
North	744,156.513
East	1,639,472.487
Theta Angle	
Horiz. Order	
Vert. Order	
DATUM:	1983('91)
TYPE OF LANDMARK	
BRASS CAP LUNDE MARKER.	
BEARINGS ARE REFERENCED TO	
GRID NORTH AS PER SECTION DATA.	

Describe any record evidence, monument evidence, testimonial evidence or any other material evidence you considered and whether the monument was found or restored through acceptance of an obliterated evidence location.
 We found an old "10" fence to the North, evidence of a "20" fence North of it, and also evidence of the "40" fence to the North. We set the corner in the remnants of the old six strand line fence going North-South and at a location that fits all of these fences to the North which appear to fit each other within inches. As set it also fits the original distance to the North. The 1/2 mile to the South is short but it appears that this is where the shortage belongs. This corner is only about 4.5 feet off line between the section
 (see below)

Describe or show any material discrepancy between the location of the restored corner and that of the corner previously restored or reestablished.
 corners. Steve Solberg did work in the SE1/4 of Section 17 in which he would have needed this corner. I found no evidence of anyone being at this corner. I think that his corner was "on paper only" and that it was probably at the single proportionate position which would put it about 27 feet North of my corner. I can't accept that as being correct.


RECORD OF DURABLE WITNESS MONUMENTS

NO	DESCRIPTION	MAGNETIC	
		BEARING	DISTANCE
1	SET A NAIL IN S.-SIDE OF A 10-1/2" HICKORY	N 80° W	36.04 FT.
2	SET A NAIL IN N.E.-SIDE OF A 9-1/2" HICKORY	N 29° W	25.30 FT.
3	SET A NAIL IN S.E.-SIDE OF A 36"± OAK	N 07° E	36.37 FT.
4	SET A NAIL IN S.E.-SIDE OF A 10-1/2" OAK	N 22° E	25.63 FT.

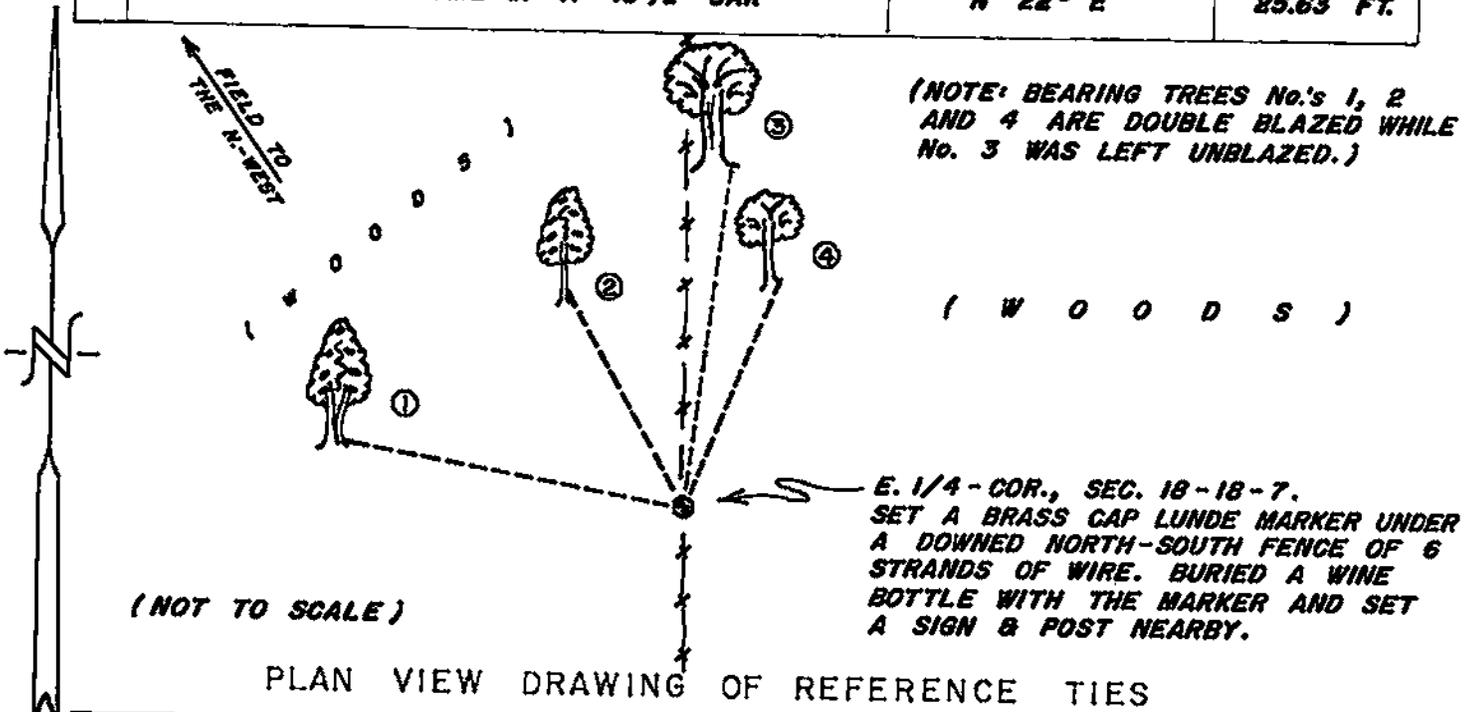

MAP SHOWING DISTANCE AND DIRECTION TO OTHER PUBLIC LAND SURVEY CORNERS USED FOR REESTABLISHING THE CORNER

(GRID BEARINGS AND DISTANCES)
(GRID FACTOR: 0.999965)
(NOT TO SCALE)

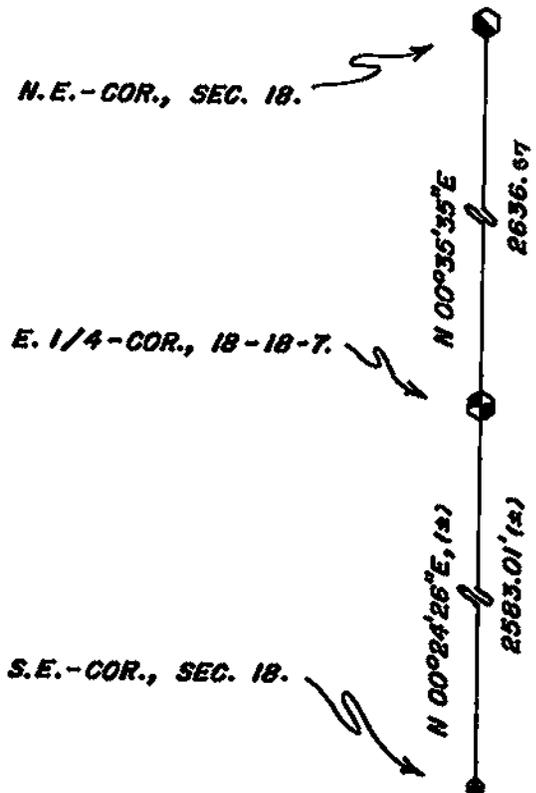

I, WILLIAM C. JUNG, COUNTY SURVEYOR
HEREBY CERTIFY THAT THE CORNER LOCATION SHOWN ON THIS RECORD WAS DETERMINED BY ME OR UNDER MY DIRECTION AND CONTROL AND THAT THIS U. S. PUBLIC LAND SURVEY MONUMENT RECORD IS CORRECT AND COMPLETE TO THE BEST OF MY KNOWLEDGE AND BELIEF.

William C. Jung
Signature

10/19/07
Date



Seal