


U. S. PUBLIC LAND SURVEY MONUMENT RECORD

SECTION 30 T 18 N, R 7 W, TOWN OF HOLLAND

LA CROSSE COUNTY

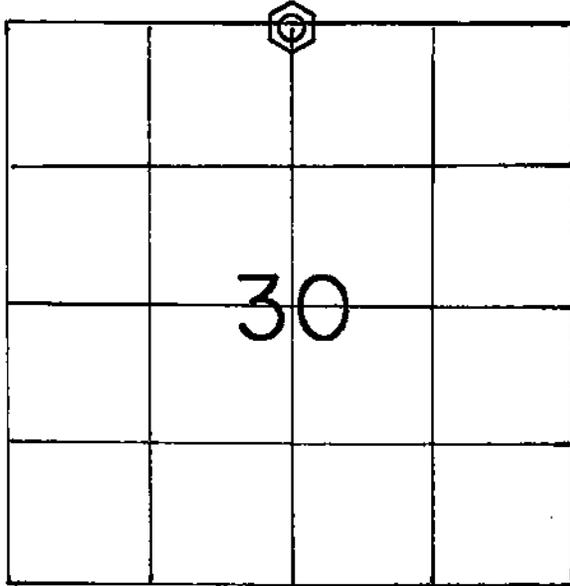

LOCATION OF LANDMARK

WISCONSIN COORDINATE SYSTEM

North

East

Theta Angle

Horiz. Order

Vert. Order

TYPE OF LANDMARK

Brass cap Lunde Top on an Iron Pipe.

BEARINGS ARE REFERENCED TO

True North.

Crew: WILLIAM C. JUNG
 PETER F. FOLLANSBEE
 Date: 6/27/1995

Describe any record evidence, monument evidence, testimonial evidence or any other material evidence you considered and whether the monument was found or restored through acceptance of an obliterated evidence location.


I set the corner by single proportionate measurement and monumented it with a brass capped Lunde Top on an Iron Pipe.

Describe or show any material discrepancy between the location of the restored corner and that of the corner previously restored or reestablished.


None Known.

RECORD OF DURABLE WITNESS MONUMENTS
MAGNETIC

NO	DESCRIPTION	BEARING	DISTANCE
1	Set P.K. Nail in NW-side 18" Oak	N 26° E	62.70' ±
2	Set P.K. Nail in NW-side 15" Oak	N 26° E	43.39' ±
3	Set P.K. Nail in NW-side 8" Hickory	N 26° E	35.45' ±
4	Set P.K. Nail in NE-side 7" trunk of Birch SINGLE BLAZED	N 73° W	41.51 Ft.

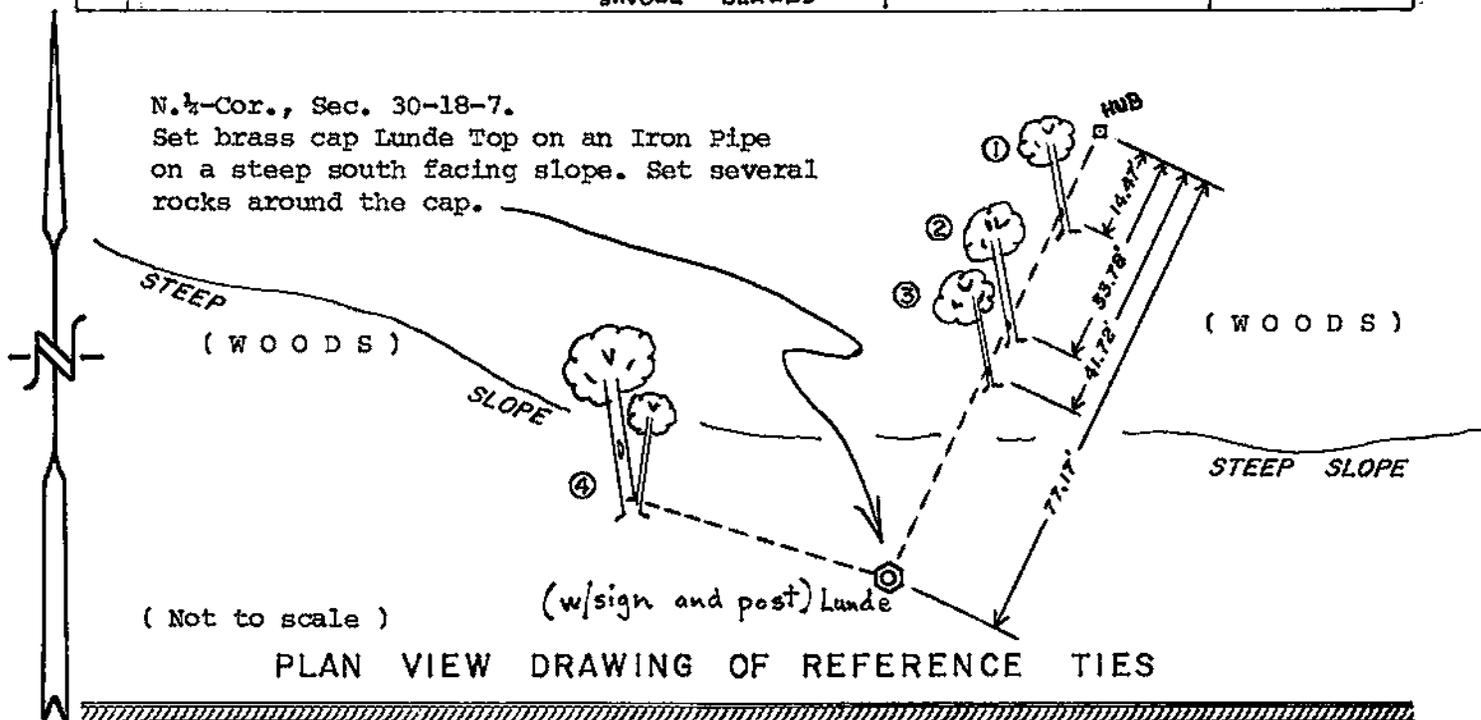


MAP SHOWING DISTANCE AND DIRECTION TO OTHER PUBLIC LAND SURVEY CORNERS USED FOR REESTABLISHING THE CORNER
(Not to scale)

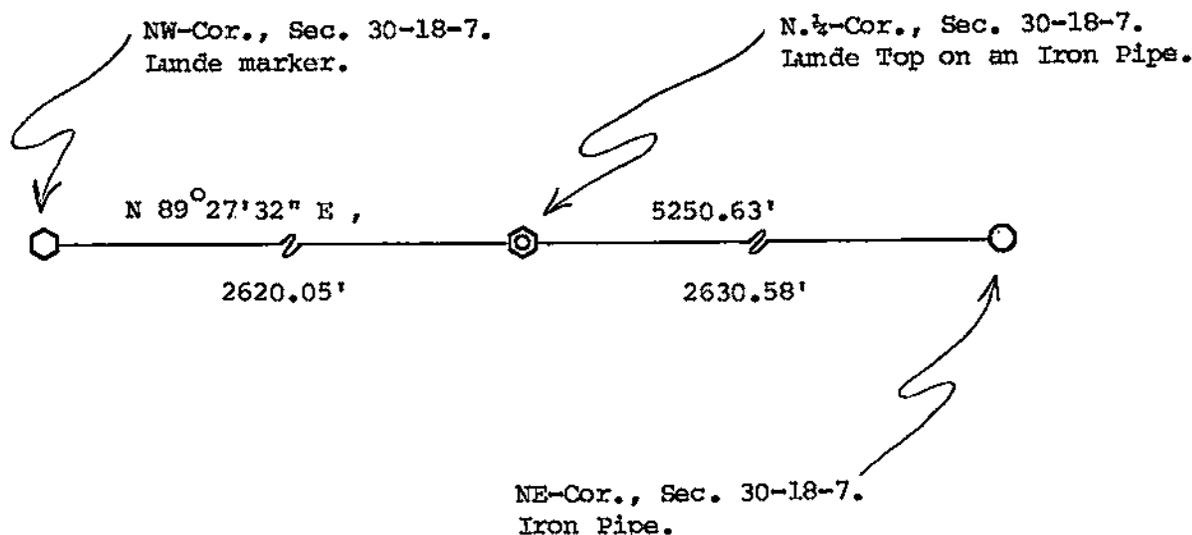

I, William C. Jung, County Surveyor
HEREBY CERTIFY THAT THE CORNER LOCATION SHOWN ON THIS RECORD WAS DETERMINED BY ME OR UNDER MY DIRECTION AND CONTROL AND THAT THIS U. S. PUBLIC LAND SURVEY MONUMENT RECORD IS CORRECT AND COMPLETE TO THE BEST OF MY KNOWLEDGE AND BELIEF.

William C. Jung
Signature

7/7/95
Date

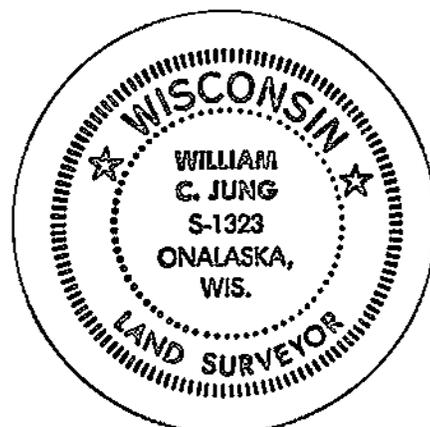

Seal