


U. S. PUBLIC LAND SURVEY MONUMENT RECORD

SECTION 29 T 18 N, R 7 W, TOWN OF HOLLAND
 LA CROSSE COUNTY

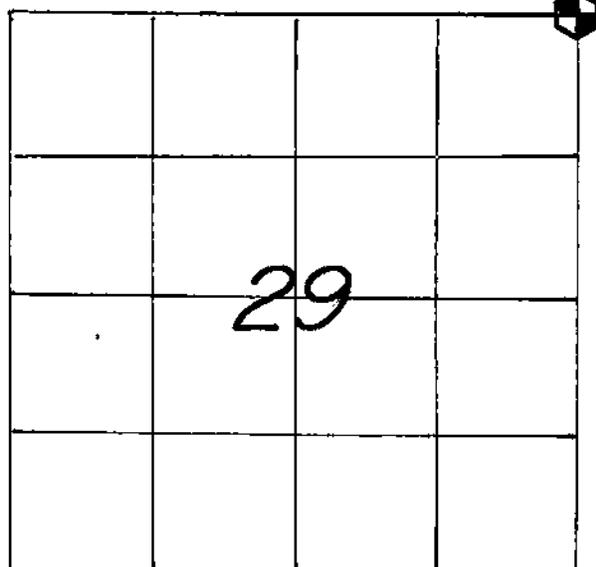

WISCONSIN COORDINATE SYSTEM

North **736,249.560**East **1,644,689.758**

Theta Angle

Horiz. Order

Vert. Order

DATUM: '83 ('91)

TYPE OF LANDMARK

BRASS CAP LUNDE MARKER.

BEARINGS ARE REFERENCED TO

GRID NORTH AS PER SECTION DATA.

LOCATION OF LANDMARK

CREW: **WILLIAM G. JUNG****PETER F. FOLLANSBEE**DATE: **9/10/2001**

Describe any record evidence, monument evidence, testimonial evidence or any other material evidence you considered and whether the monument was found or restored through acceptance of an obliterated evidence location.

I reviewed the surveys of record, especially Bob Chalsma's, at great length. I agree with Bob's computed location of this corner. He never set a monument. My location best fits where Bob intended the corner to be. Set as such it would appear that all corners of record (1/4, C1/4, "40", etc.) should and could be accepted as they should and would fit the standard. I set a Lunde at the corner.

Describe or show any material discrepancy between the location of the restored corner and that of the corner previously restored or reestablished.

NONE KNOWN.

