


2180⁷200020

U. S. PUBLIC LAND SURVEY MONUMENT RECORD

SECTION 29 T 18 N, R 7 W, TOWN OF HOLLAND
 LA CROSSE COUNTY

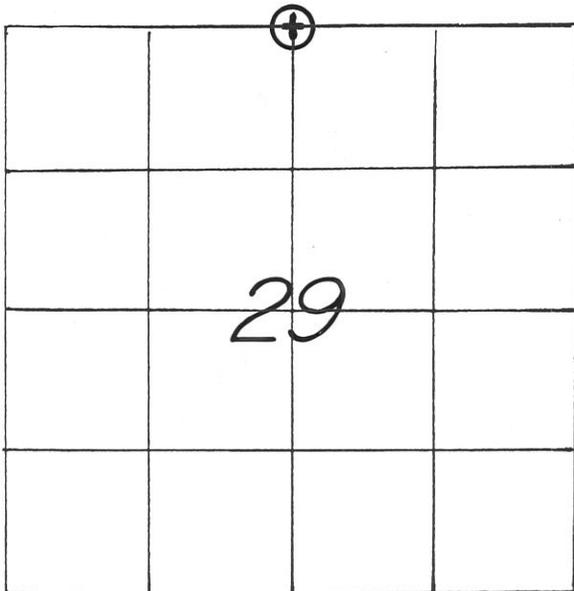

WISCONSIN COORDINATE SYSTEM

North 736,277.601

East 1,642,051.687

Theta Angle

Horiz. Order

Vert. Order

DATUM: 1983 ('91)

TYPE OF LANDMARK

3/4" x 30" IRON BAR WITH ALUMINUM CAP.

BEARINGS ARE REFERENCED TO

GRID NORTH AS PER SECTION DATA.

LOCATION OF LANDMARK

CREW: WILLIAM C. JUNG
 PETER F. FOLLANSBEE
 DATE: 11/06/2001

Describe any record evidence, monument evidence, testimonial evidence or any other material evidence you considered and whether the monument was found or restored through acceptance of an obliterated evidence location.

I set this corner "by law" at the single proportionate position.

Describe or show any material discrepancy between the location of the restored corner and that of the corner previously restored or reestablished.

Bob Chalsma had two positions for this corner that did not agree. One was at the single proportionate position.

RECORD OF DURABLE WITNESS MONUMENTS
MAGNETIC


NO	DESCRIPTION	BEARING	DISTANCE
1	SET A NAIL IN S.E.-SIDE OF A 13" DOUBLE OAK. (w/ sign)	N 15° E	5.12 FT.
2	SET A NAIL IN S.E.-SIDE OF AN 8" OAK	N 50° E	17.28 FT.
3	SET A NAIL IN S.-SIDE OF A 5" BASSWOOD	S 89° E	11.00 FT.
4	SET A NAIL IN S.W.-SIDE OF AN 11" HICKORY	S 20° E	7.67 FT.

(NOT TO SCALE)

(NOTE: THE FOUR BEARING TREES ARE DOUBLE BLAZED.)

(WOODS)


N. 1/4 - COR., SEC. 29 - 18 - 7.
SET A 3/4" x 30" IRON BAR WITH AN ALUMINUM CAP FLUSH TO THE GROUND ON A BRUSHY WEST FACING SIDE SLOPE.

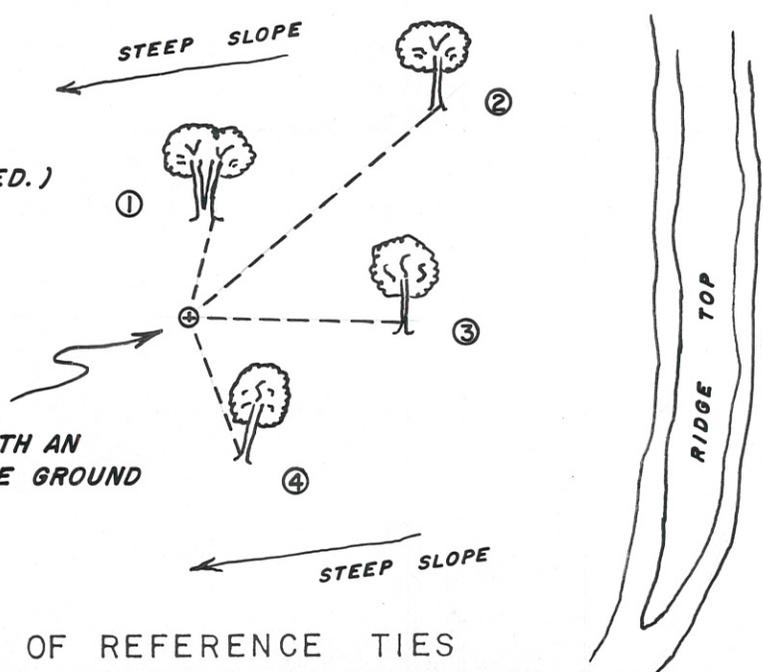

PLAN VIEW DRAWING OF REFERENCE TIES

MAP SHOWING DISTANCE AND DIRECTION TO OTHER PUBLIC LAND SURVEY CORNERS USED FOR REESTABLISHING THE CORNER

(GRID BEARINGS & DISTANCES)
(GRID FACTOR: 0.9999468)
(NOT TO SCALE)

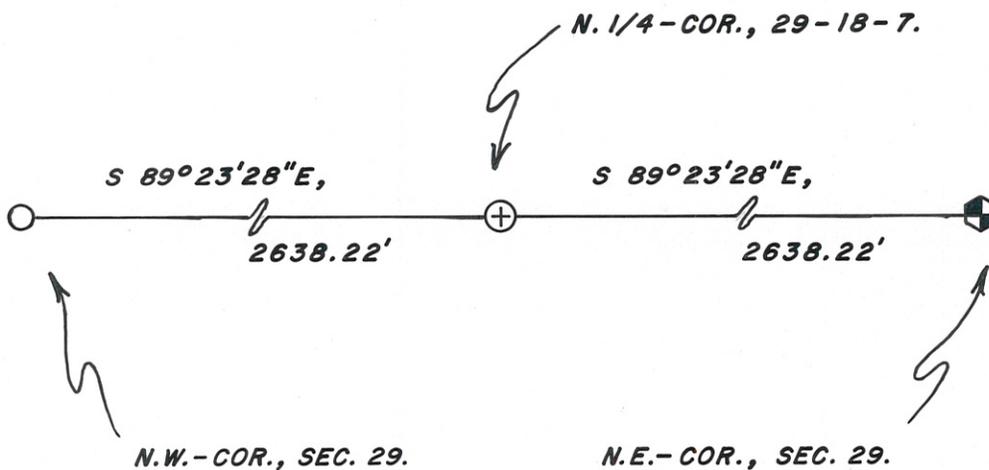

I, WILLIAM C. JUNG, COUNTY SURVEYOR
HEREBY CERTIFY THAT THE CORNER LOCATION SHOWN ON THIS RECORD WAS DETERMINED BY ME OR UNDER MY DIRECTION AND CONTROL AND THAT THIS U. S. PUBLIC LAND SURVEY MONUMENT RECORD IS CORRECT AND COMPLETE TO THE BEST OF MY KNOWLEDGE AND BELIEF.

William C. Jung 1/02/02
Signature Date



Seal