


21807210020

U. S. PUBLIC LAND SURVEY MONUMENT RECORD

SECTION 21 T 18 N, R 7 W, TOWN OF HOLLAND

LA CROSSE COUNTY

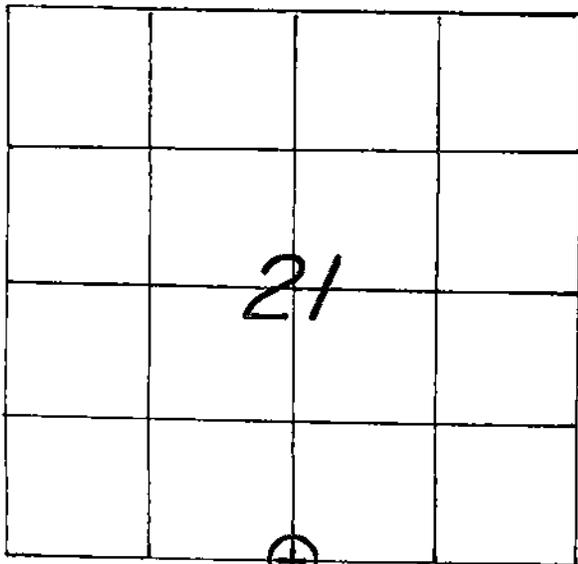

LOCATION OF LANDMARK

CREW: **WILLIAM G. JUNG**  
**PETER F. FOLLANSBEE**  
 DATE: **3/10/2006**

WISCONSIN COORDINATE SYSTEM
North
East
Theta Angle
Horiz. Order
Vert. Order

TYPE OF LANDMARK  
**IRON BAR WITH ALUMINUM CAP IN IRON PIPE.**

BEARINGS ARE REFERENCED TO  
**LACROSSE COUNTY COORDINATE SYSTEM NORTH AS PER SECTION DATA.**

Describe any record evidence, monument evidence, testimonial evidence or any other material evidence you considered and whether the monument was found or restored through acceptance of an obliterated evidence location.

I found an iron pipe at the corner that had been used as the corner in previous survey work of record. I set an iron bar with a cap inside the pipe and drove it down. I accepted this location as the best available evidence of the original government corner position.

Describe or show any material discrepancy between the location of the restored corner and that of the corner previously restored or reestablished.


**NONE KNOWN.**

RECORD OF DURABLE WITNESS MONUMENTS

NO	DESCRIPTION	MAGNETIC	
		BEARING	DISTANCE
1	SET A NAIL IN N.W.-SIDE OF A 19" WHITE OAK	N 48° E	34.71 FT.
2	SET A NAIL IN S.W.-SIDE OF AN 8 1/2" WHITE OAK	S 56° E	SLOPE = 52.95'
3	SET A NAIL IN S.E.-SIDE OF A 10" WHITE OAK	S 26° W	30.14 FT.
4	SET A NAIL IN S.E.-SIDE OF A 12 1/2" WHITE OAK	S 44° W	37.63 FT.

(NOTE: THE FOUR BEARING TREES ARE DOUBLE BLAZED.)


(NOT TO SCALE)

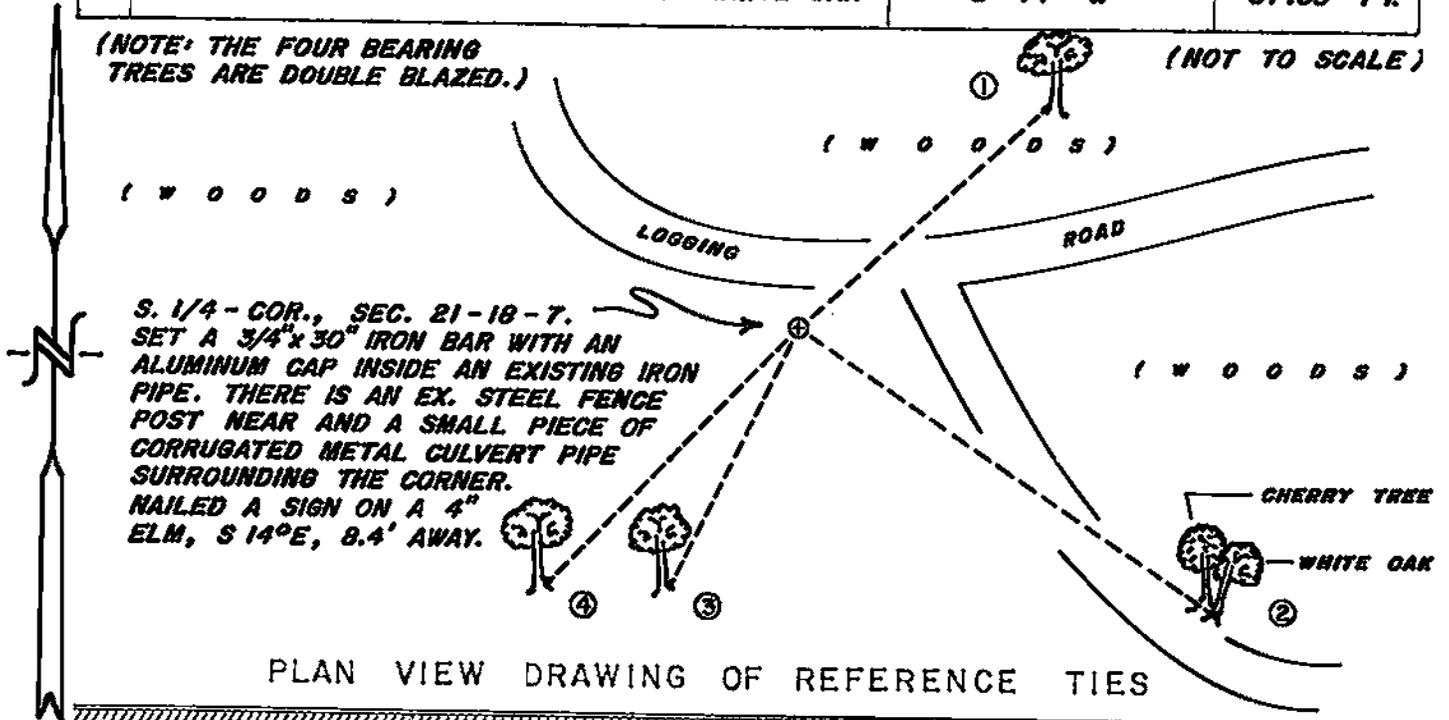

PLAN VIEW DRAWING OF REFERENCE TIES


MAP SHOWING DISTANCE AND DIRECTION TO OTHER PUBLIC LAND SURVEY CORNERS USED FOR REESTABLISHING THE CORNER

(LACROSSE COUNTY COORDINATE SYSTEM BEARINGS)  
(P.E. FAIRCHILD MEASUREMENTS)  
(NOT TO SCALE)

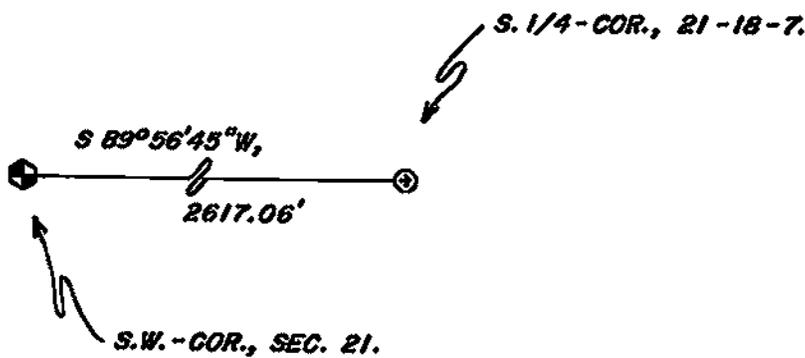

I, WILLIAM C. JUNG, COUNTY SURVEYOR  
HEREBY CERTIFY THAT THE CORNER LOCATION SHOWN ON THIS RECORD WAS DETERMINED BY ME OR UNDER MY DIRECTION AND CONTROL AND THAT THIS U. S. PUBLIC LAND SURVEY MONUMENT RECORD IS CORRECT AND COMPLETE TO THE BEST OF MY KNOWLEDGE AND BELIEF.

William C. Jung                      4/1/06  
Signature                                      Date

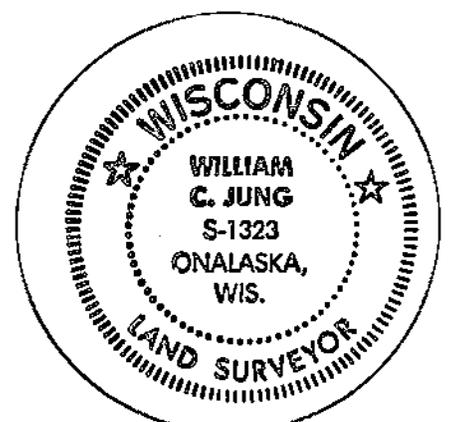

Seal