


U. S. PUBLIC LAND SURVEY MONUMENT RECORD

SECTION 27 T 18 N, R 7 W, TOWN OF Farmington

LA CROSSE COUNTY

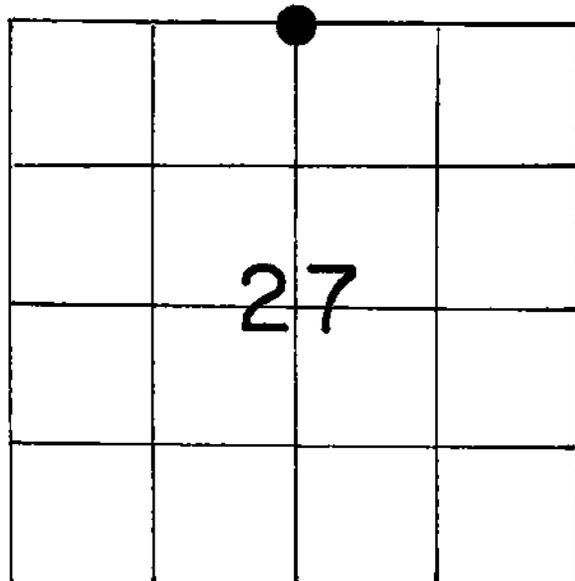

LOCATION OF LANDMARK

Crew: William C. Jung
Peter Follansbee

Date: 9/27/88

Describe any record evidence, monument evidence, testimonial evidence or any other material evidence you considered and whether the monument was found or restored through acceptance of an obliterated evidence location.

Norm Hurlburt "ran out" Section 27 and concluded that this corner should be set by single proportionate measurement. I set the corner by this method using Hurlburt's survey points and coordinates. The corner is a brass capped Lunde marker. While digging I found three strands of wire going North-South in the corner area. Also, about 25'± to the E-SE of the corner I found a hole which appears to be an old tree hole. One of the original bearing trees was a 14" white oak, S88°E, 25' to center of tree. If this was the tree hole, it fits the final corner very well.

Describe or show any material discrepancy between the location of the restored corner and that of the corner previously restored or reestablished.

None known.

WISCONSIN COORDINATE SYSTEM

North

East

Theta Angle

Horiz. Order

Vert. Order

TYPE OF LANDMARK

Brass capped Lunde marker

BEARINGS ARE REFERENCED TO

Assumed

