


U. S. PUBLIC LAND SURVEY MONUMENT RECORD

SECTION 26 T 18 N, R 7 W, TOWN OF Farmington

LA CROSSE COUNTY

"The Badger Corner"

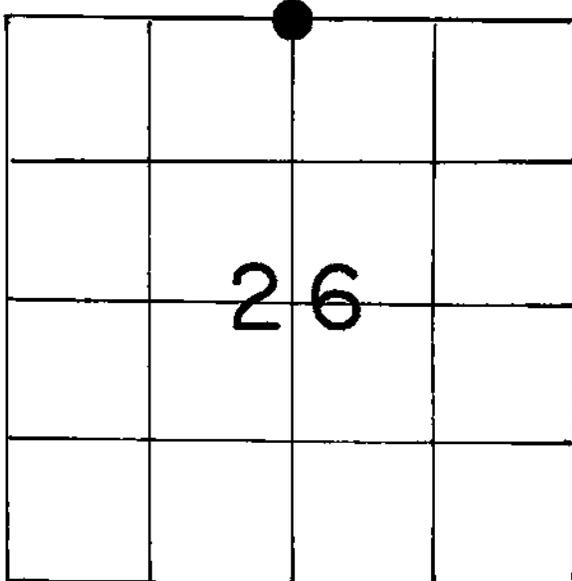

LOCATION OF LANDMARK

WISCONSIN COORDINATE SYSTEM

North

East

Theta Angle

Horiz. Order

Vert. Order

TYPE OF LANDMARK

Brass capped Lunde marker

BEARINGS ARE REFERENCED TO

Assumed

Crew: William C. Jung
Peter Follansbee

Date: 6/21/88

Describe any record evidence, monument evidence, testimonial evidence or any other material evidence you considered and whether the monument was found or restored through acceptance of an obliterated evidence location.

I accepted the occupied field conditions as the best available evidence of the original government corner position and monumented the corner with a brass capped Lunde marker. The corner is set flush by a "dead log".

Describe or show any material discrepancy between the location of the restored corner and that of the corner previously restored or reestablished.

Clayton Solberg and Dick Berg both measured to this corner. I did not find any previous monumentation. I am assuming however that I am very close to the corner that they used.

