


21807232000

U. S. PUBLIC LAND SURVEY MONUMENT RECORD

SECTION 23 T 18 N, R 7 W, TOWN OF FARMINGTON  
 LA CROSSE COUNTY

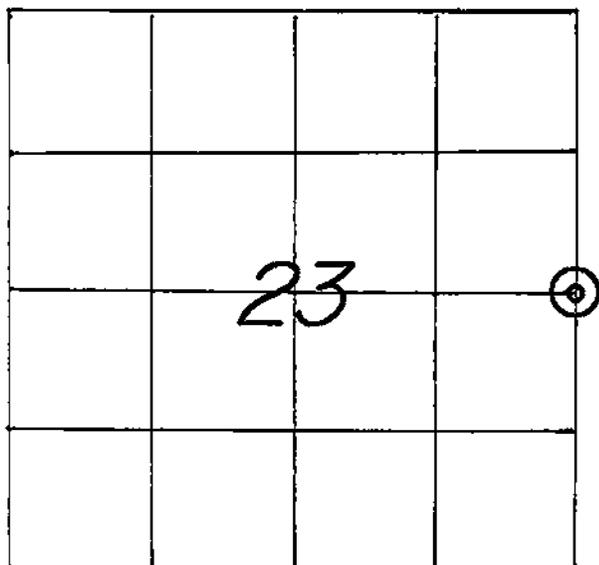

WISCONSIN COORDINATE SYSTEM
North
East
Theta Angle
Horiz. Order
Vert. Order
TYPE OF LANDMARK :
<b>P.K. NAIL IN PAVEMENT.</b>
BEARINGS ARE REFERENCED TO

LOCATION OF LANDMARK

CREW: **WILLIAM C. JUNG**  
**PETER F. FOLLANSBEE**  
 DATE: **6/13/2002**

Crew: William C. Jung  
 Peter F. Follansbee  
 Date: 4/29/04

Describe any record evidence, monument evidence, testimonial evidence or any other material evidence you considered and whether the monument was found or restored through acceptance of an obliterated evidence location.

Norm Hurlburt set a P.K. nail at this corner in 1990. He used <sup>it</sup> in another survey last fall. I agree with the placement of this corner and tied it off.


4/29/04 - Norm's P.K. nail was destroyed when the highway was repaved in 2003. We set another P.K. nail and cap at the old location.

Describe or show any material discrepancy between the location of the restored corner and that of the corner previously restored or reestablished.

**NONE KNOWN.**

RECORD OF DURABLE WITNESS MONUMENTS

	NO	DESCRIPTION	BEARING	DISTANCE
Fd.	1	<del>SET A 3/4" x 26" REBAR DOWN 7"s, 5' N. OF PAVEMENT</del>	N. WESTERLY ±	25.43 FT.
	2	<del>SET A 3/4" x 27" REBAR DOWN 5"s, 5' N. OF PAVEMENT</del>	NORTHERLY ±	6.32 FT.
Fd.	3	<del>SET A 3/4" x 33" REBAR DOWN 7"s, 5' N. OF PAVEMENT</del>	N. EASTERLY ±	26.06 FT.
Fd.	4	<del>SET A 3/4" x 35" REBAR DOWN 8"s, 5' S. OF PAVEMENT</del>	SOUTHERLY ±	26.12 FT.

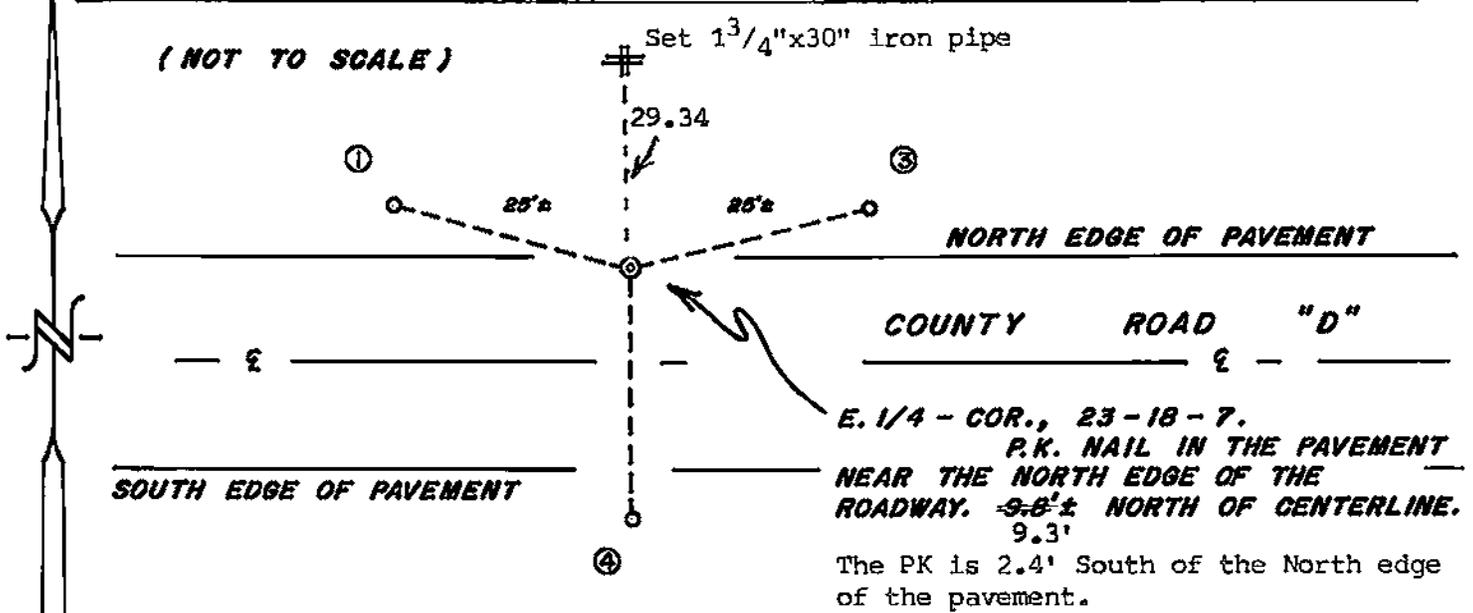

PLAN VIEW DRAWING OF REFERENCE TIES


MAP SHOWING DISTANCE AND DIRECTION TO OTHER PUBLIC LAND SURVEY CORNERS USED FOR REESTABLISHING THE CORNER

No section measurements were made by me at this time. Hurlburt's measurements confirmed the location of this corner.

I, WILLIAM C. JUNG, COUNTY SURVEYOR  
 HEREBY CERTIFY THAT THE CORNER LOCATION SHOWN ON THIS RECORD WAS DETERMINED BY ME OR UNDER MY DIRECTION AND CONTROL AND THAT THIS U. S. PUBLIC LAND SURVEY MONUMENT RECORD IS CORRECT AND COMPLETE TO THE BEST OF MY KNOWLEDGE AND BELIEF.

William C. Jung 6/27/02  
 Signature Date

Revised: 1/24/05 *W.C.J.*

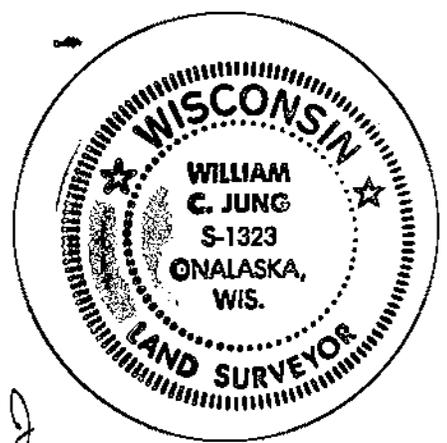

Seal