


U. S. PUBLIC LAND SURVEY MONUMENT RECORD

SECTION 25 T 18 N, R 7 W, TOWN OF Farmington

LA CROSSE COUNTY

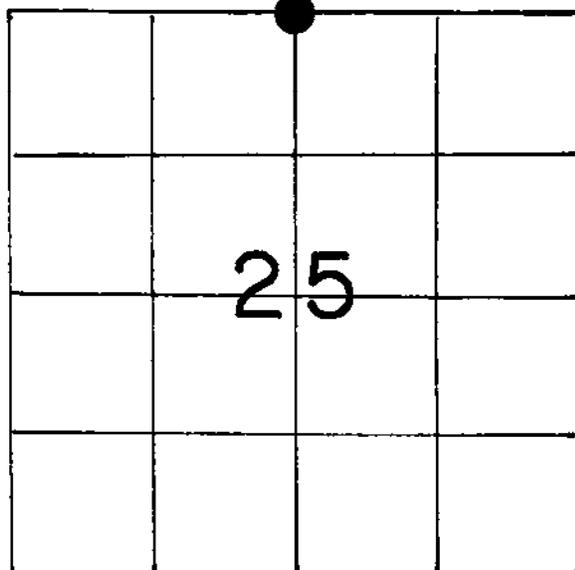

LOCATION OF LANDMARK

Crew: William C. Jung
Peter Follansbee

Date: 11/1/ 88

WISCONSIN COORDINATE SYSTEM

North

East

Theta Angle

Horiz. Order

Vert. Order

TYPE OF LANDMARK

Brass capped Lunde marker

BEARINGS ARE REFERENCED TO

Describe any record evidence, monument evidence, testimonial evidence or any other material evidence you considered and whether the monument was found or restored through acceptance of an obliterated evidence location.


I found an old rotted 18" white oak stump, up 8',₀ that I believe is an original bearing tree. The original was a 4" white oak, N4° W, 32.5 feet to the center of of the tree. "Pulling" off the stump puts me just East of the old occupied fence corner. I accepted the stump as the remains of the original tree and set the corner as per the original notes. I set a brass capped Lunde marker. 1' East of the old occupied corner. The Lunde marker is up 1". As a memorial, I buried a whiskey bottle with an empty cartridge South of the Lunde marker.

Describe or show any material discrepancy between the location of the restored corner and that of the corner previously restored or reestablished.

None known.

RECORD OF DURABLE WITNESS MONUMENTS

NO	DESCRIPTION	BEARING	DISTANCE
1	P.K. nail in unblazed 7" cedar	-----	8.30
2	P.K. nail in 5" double blazed hickory	-----	23.61
3	" " " 4" " " "	-----	13.38
4	" " " 5" " " "	-----	15.32

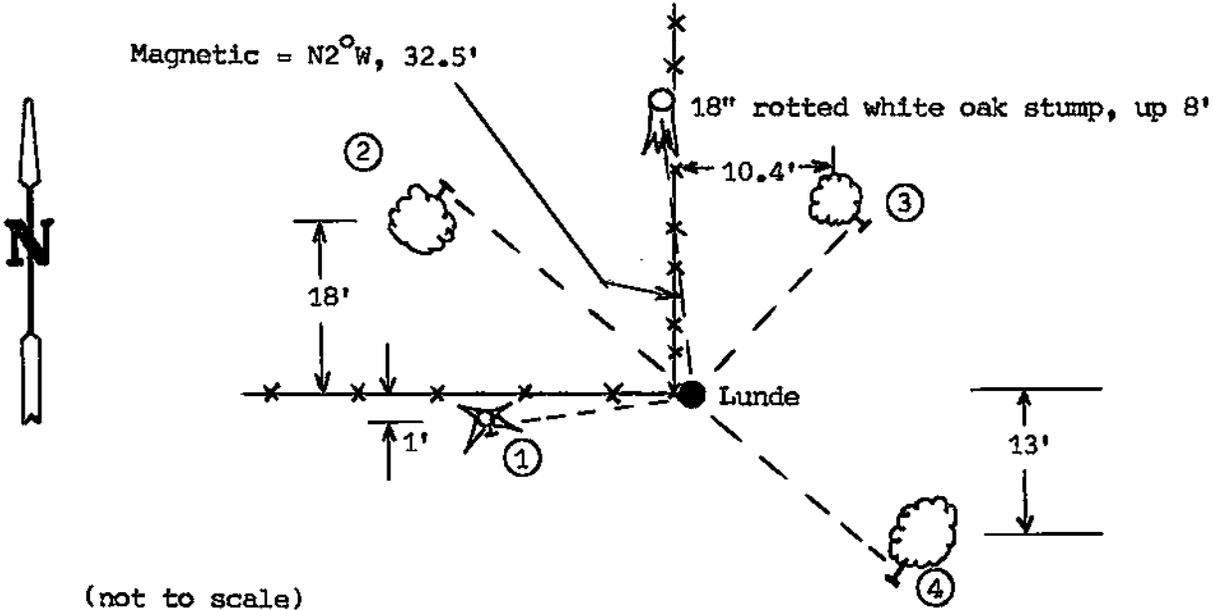

PLAN VIEW DRAWING OF REFERENCE TIES


MAP SHOWING DISTANCE AND DIRECTION TO OTHER PUBLIC LAND SURVEY CORNERS USED FOR REESTABLISHING THE CORNER

I chained along the North line of the NW1/4 of Section 25 so that I could verify this point as the 1/4 corner. I do not have final bearing and distance on this line at this time. The final distance along the North line of said NW1/4 is however approximately 2613 feet ±. The original distance was 2616.9 feet.

I, William C. Jung, Deputy County Surveyor,
 HEREBY CERTIFY THAT THE CORNER LOCATION SHOWN ON THIS RECORD
 WAS DETERMINED BY ME OR UNDER MY DIRECTION AND CONTROL AND
 THAT THIS U. S. PUBLIC LAND SURVEY MONUMENT RECORD IS CORRECT
 AND COMPLETE TO THE BEST OF MY KNOWLEDGE AND BELIEF.

William C. Jung
 Signature

1/23/89
 Date

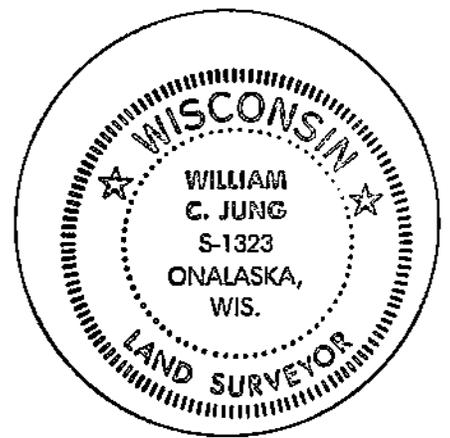

Seal