


21807250020

## U. S. PUBLIC LAND SURVEY MONUMENT RECORD

SECTION 25 T 18 N, R 7 W, TOWN OF Farmington

LA CROSSE COUNTY

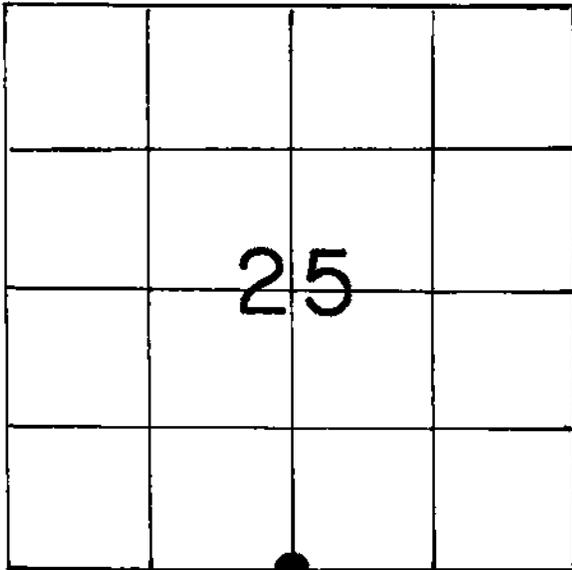

LOCATION OF LANDMARK

Crew: William C. Jung  
Peter Follansbee

Date: 10/31/88

Describe any record evidence, monument evidence, testimonial evidence or any other material evidence you considered and whether the monument was found or restored through acceptance of an obliterated evidence location.

I set the corner at a location that fits the intersection of the fences projected from the West, South, East, and North. I accepted the occupied corner as the best available evidence of the original government corner position. I set a 1½"x23" iron pipe over a 1"x30" iron pipe, flush, in the water and West of the road culvert. I could not set a Lunde marker in this area. The pipe is drove down so that the horses will not step on it.

Describe or show any material discrepancy between the location of the restored corner and that of the corner previously restored or reestablished.

None known.

## WISCONSIN COORDINATE SYSTEM

North

East

Theta Angle

Horiz. Order

Vert. Order

## TYPE OF LANDMARK


1½" iron pipe over 1" iron pipe

## BEARINGS ARE REFERENCED TO

Assumed

RECORD OF DURABLE WITNESS MONUMENTS


NO	DESCRIPTION	BEARING	DISTANCE
1	Set 1" iron pipe	South $\pm$	26.70
2	To the center of the Southeast corner wood post of the most Southerly shed	-----	202.3
3	Set 1" iron pipe	West $\pm$	29.00
4	End of projecting angle iron at top of stone culvert on the South side	East $\pm$	12.77

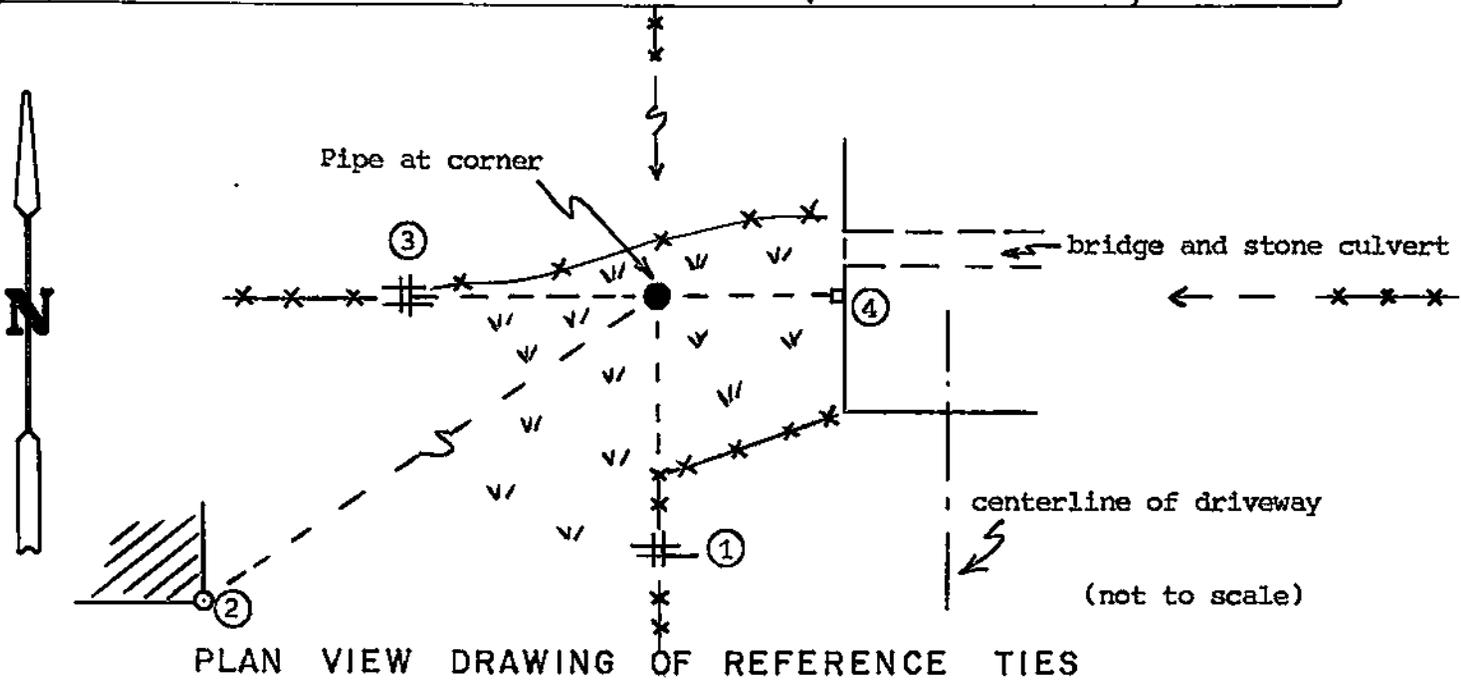

PLAN VIEW DRAWING OF REFERENCE TIES


MAP SHOWING DISTANCE AND DIRECTION TO OTHER PUBLIC LAND SURVEY CORNERS USED FOR REESTABLISHING THE CORNER

(not to scale)

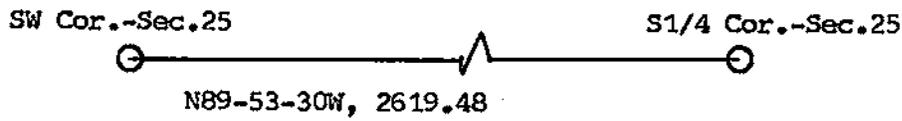

I, William C. Jung, Deputy County Surveyor,  
 HEREBY CERTIFY THAT THE CORNER LOCATION SHOWN ON THIS RECORD  
 WAS DETERMINED BY ME OR UNDER MY DIRECTION AND CONTROL AND  
 THAT THIS U. S. PUBLIC LAND SURVEY MONUMENT RECORD IS CORRECT  
 AND COMPLETE TO THE BEST OF MY KNOWLEDGE AND BELIEF.

William C. Jung 1/23/89  
 Signature Date

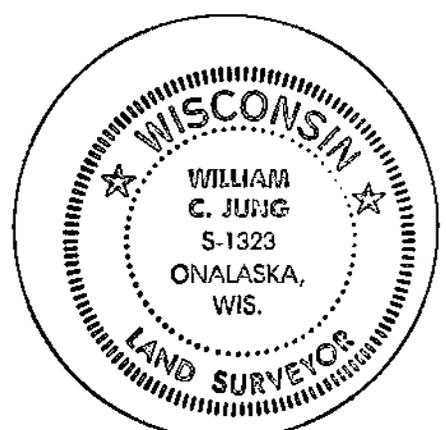

Seal