


21807260000

U. S. PUBLIC LAND SURVEY MONUMENT RECORD

SECTION 26 T 18 N, R 7 W, TOWN OF Farmington

LA CROSSE COUNTY

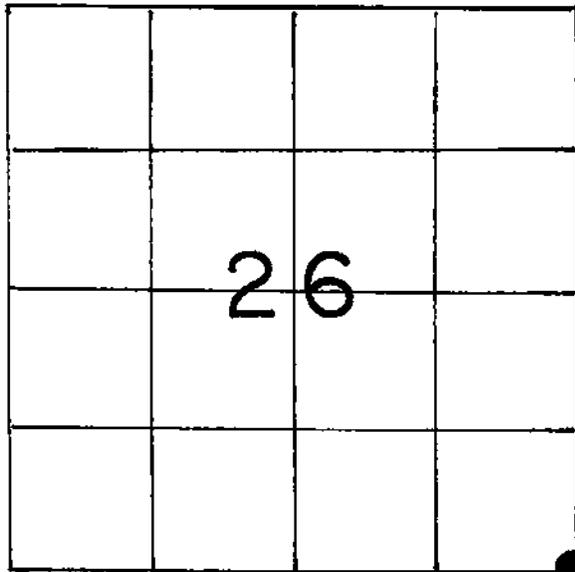

LOCATION OF LANDMARK

Crew: William C. Jung
Peter Follansbee

Date: 10/31/88

Crew: William C. Jung
Peter Follansbee

Date: 5/24/96

Describe any record evidence, monument evidence, testimonial evidence or any other material evidence you considered and whether the monument was found or restored through acceptance of an obliterated evidence location.

I found old North-South wire about 62.5' South of my corner. I "pushed" a line North from the West 1/4 Corner of Section 36 through this North-South wire and intersected this line with the occupied North line of the NE1/4-NW1/4 of said Section 36 "pushed" West. This fits the East line of Section 26 and the West line of Section 36 very well. The 1/2 mile distance South of this corner is short, but this is understandable considering the bluff to the South. The 1/2 mile to the East of this corner fits the original notes within 3.36' I set a brass capped Lunde marker at the corner.

Describe or show any material discrepancy between the location of the restored corner and that of the corner previously restored or reestablished.

None known.

WISCONSIN COORDINATE SYSTEM

North

East

Theta Angle

Horiz. Order

Vert. Order

TYPE OF LANDMARK

Brass capped Lunde marker

BEARINGS ARE REFERENCED TO

Assumed


RECORD OF DURABLE WITNESS MONUMENTS

NO	DESCRIPTION	Magnetic	
		BEARING	DISTANCE
1	P.K. nail in double blazed 14" white oak	S48°W S50°W	24.42 23.97
2	" " " " " 6" " "	N38°W N37°W	22.32 22.90
3	" " " " " 18" " "	N57°E N60°E	52.73 53.06
4	" " " " " 5" " "	S41°E	31.72

(not to scale)


5/24/96 - I made an error when I set this corner in 1988. The new ties reflect the Lunde in its correct position. A sign and post were set to the South too.

Set a brass capped Lunde marker. Buried a gin bottle with a blank bullet as a memorial to the South of the marker. Also set a hickory post South of the marker.

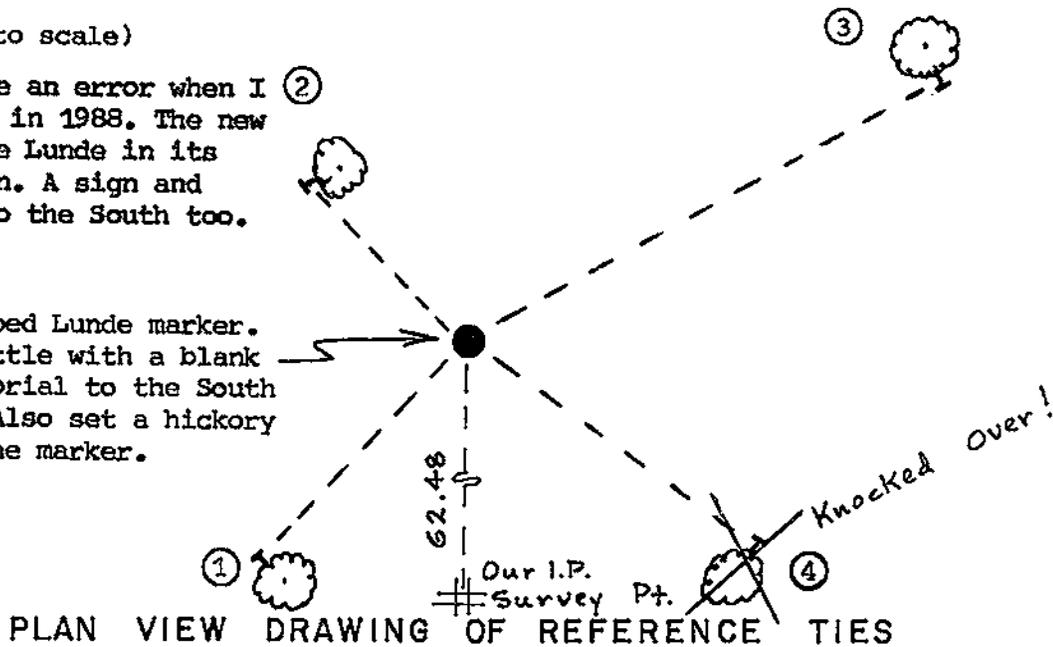

MAP SHOWING DISTANCE AND DIRECTION TO OTHER PUBLIC LAND SURVEY CORNERS USED FOR REESTABLISHING THE CORNER

(not to scale)

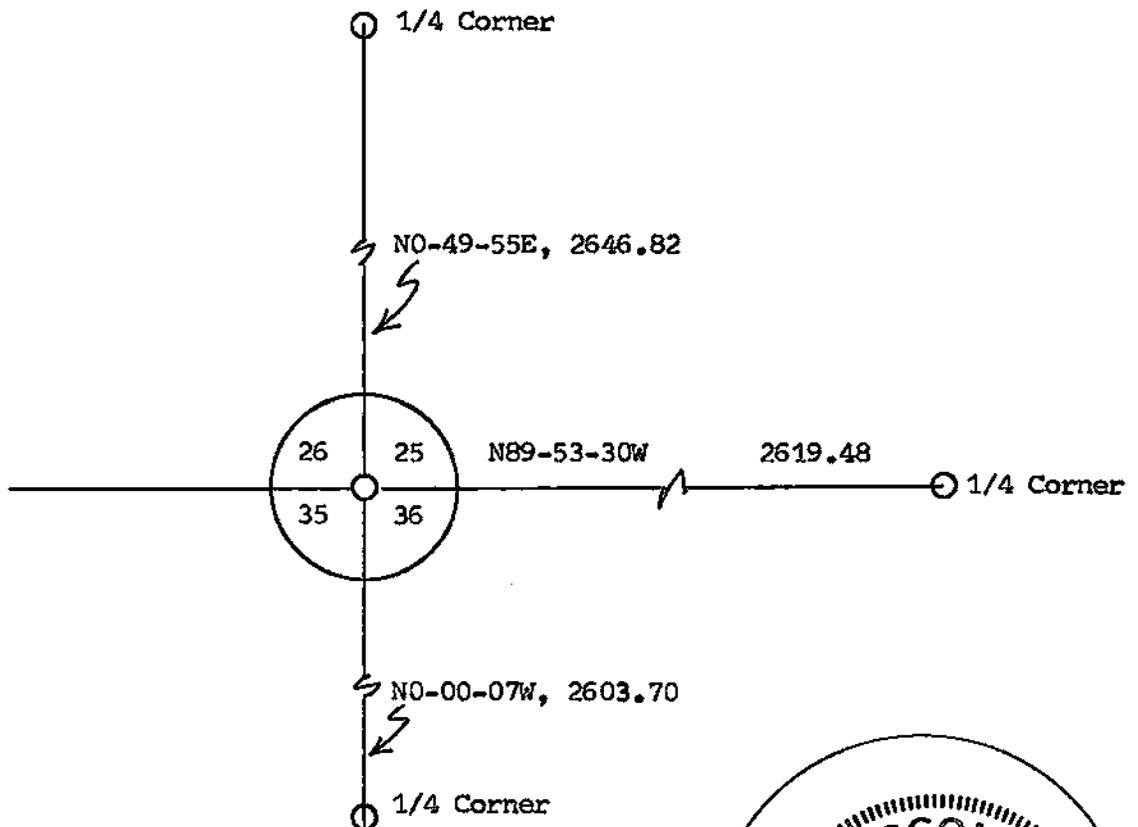

I, William C. Jung, Deputy County Surveyor,
 HEREBY CERTIFY THAT THE CORNER LOCATION SHOWN ON THIS RECORD
 WAS DETERMINED BY ME OR UNDER MY DIRECTION AND CONTROL AND
 THAT THIS U. S. PUBLIC LAND SURVEY MONUMENT RECORD IS CORRECT
 AND COMPLETE TO THE BEST OF MY KNOWLEDGE AND BELIEF.

William C. Jung
 Signature 1/23/89
 Revised: 12/3/96 Date
 wey



Seal