


U. S. PUBLIC LAND SURVEY MONUMENT RECORD

SECTION 26 T 18 N, R 7 W, TOWN OF Farmington

LA CROSSE COUNTY

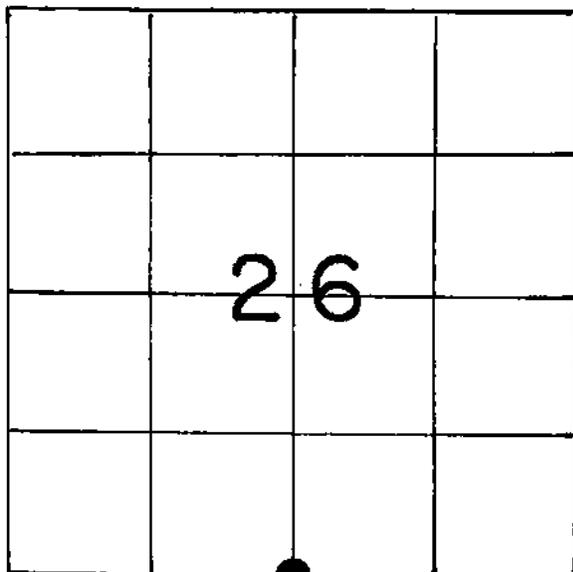

LOCATION OF LANDMARK

WISCONSIN COORDINATE SYSTEM
North
East
Theta Angle
Horiz. Order
Vert. Order
TYPE OF LANDMARK
Berntsen Marker
BEARINGS ARE REFERENCED TO
Assumed

Crew: William C. Jung

Date: 11/14/88

Describe any record evidence, monument evidence, testimonial evidence or any other material evidence you considered and whether the monument was found or restored through acceptance of an obliterated evidence location.


I set the corner by single proportionate measurement and monumented the corner with a Berntsen marker. Phil Smith, RLS from Holmen, told me that the fence to the North was not put in on the true line, that it was put in as a pasture fence only, that John Wiggert to the South was informed of this, and that, he, Smith did not establish the section line. Smith also looked for evidence of the corner, but he like I, could not find any evidence of the corner. As a memorial, I also buried a liquor bottle with an empty M-16 cartridge on the Northwest side of the marker. I also placed a large stone Northwest of the marker. The Berntsen is 30" long.

Describe or show any material discrepancy between the location of the restored corner and that of the corner previously restored or reestablished.

None known.

RECORD OF DURABLE WITNESS MONUMENTS
Magnetic


NO	DESCRIPTION	BEARING	DISTANCE
1	P.K. nail in double blazed 12" burr oak	S89°E	38.70
2	" " " " " 9" ash (?)	S 6°E	26.26
3	" " " " " 9" white oak	N45°W	71.20
4	Set iron pipe in fence, 65' West of post	N10°W	28.53

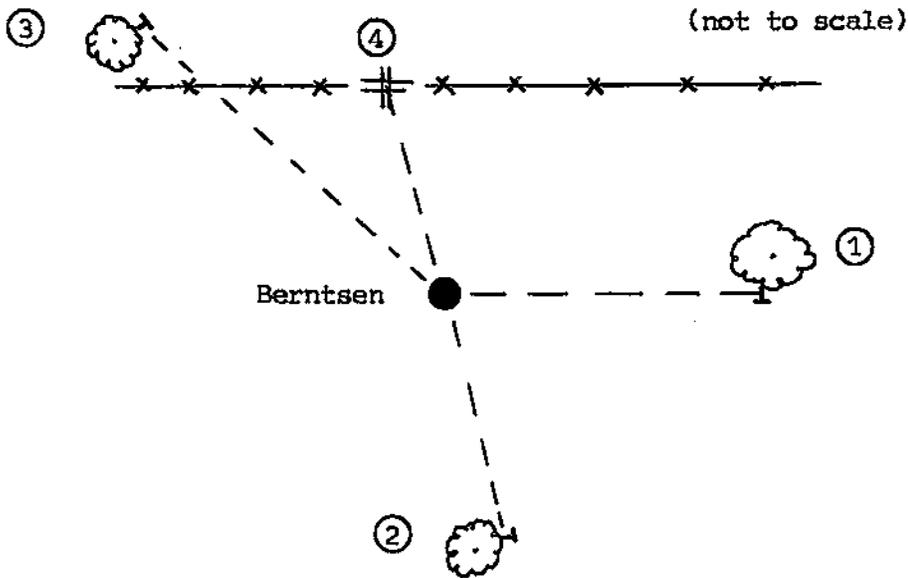

PLAN VIEW DRAWING OF REFERENCE TIES

MAP SHOWING DISTANCE AND DIRECTION TO OTHER PUBLIC LAND SURVEY CORNERS USED FOR REESTABLISHING THE CORNER


(not to scale)

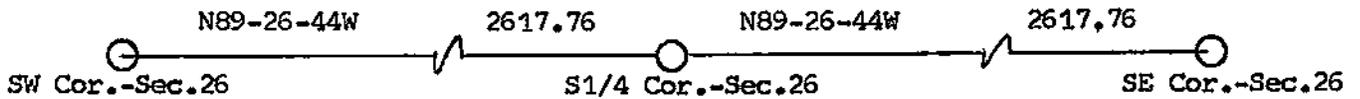

I, William C. Jung, Deputy County Surveyor,
HEREBY CERTIFY THAT THE CORNER LOCATION SHOWN ON THIS RECORD
WAS DETERMINED BY ME OR UNDER MY DIRECTION AND CONTROL AND
THAT THIS U. S. PUBLIC LAND SURVEY MONUMENT RECORD IS CORRECT
AND COMPLETE TO THE BEST OF MY KNOWLEDGE AND BELIEF.

William C. Jung
Signature

1/24/89
Date

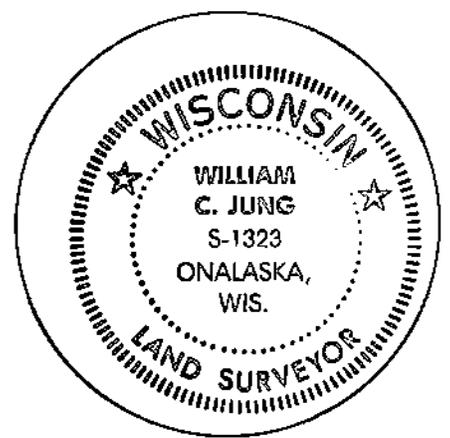

Seal