


21807262000

## U. S. PUBLIC LAND SURVEY MONUMENT RECORD

SECTION 26 T 18 N, R 7 W, TOWN OF Farmington

LA CROSSE COUNTY

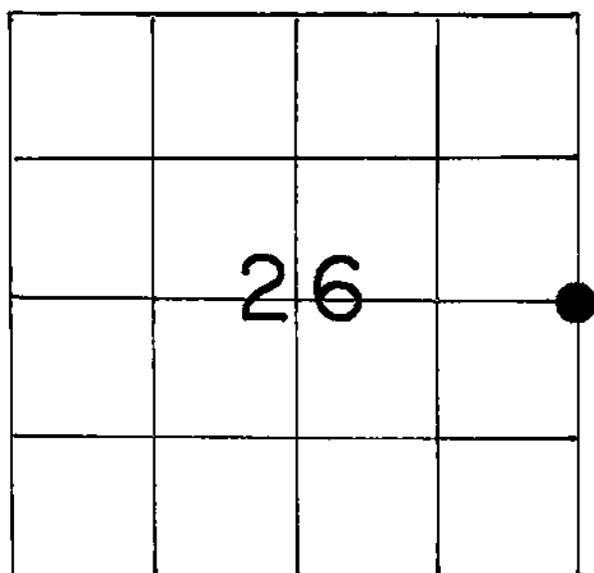

LOCATION OF LANDMARK

## WISCONSIN COORDINATE SYSTEM

North

East

Theta Angle

Horiz. Order

Vert. Order

## TYPE OF LANDMARK

Brass capped Lunde marker

## BEARINGS ARE REFERENCED TO

Assumed

Crew: William C. Jung  
Peter FollansbeeCrew: William C. Jung  
Peter Follansbee

Date: 9/27/88

Dates: 2/22/00 and 4/24/00

Describe any record evidence, monument evidence, testimonial evidence or any other material evidence you considered and whether the monument was found or restored through acceptance of an obliterated evidence location.

I accepted the old occupied fence corner as the best available evidence of the original government corner. Hermie Mikkelson, age 81 years, said that this fence corner has always been the corner and also that other surveyors have used it as the corner in the past. I monumented the corner with a brass capped Lunde marker.


2000- Due to frost action and settlement, the monument was off plumb. I reset the Lunde. I also recomputed the East line of the section as a small error was found in my original traverse.

Describe or show any material discrepancy between the location of the restored corner and that of the corner previously restored or reestablished.

None known.

RECORD OF DURABLE WITNESS MONUMENTS  
Magnetic


NO	DESCRIPTION	BEARING	DISTANCE
1	P.K. nail in a double blazed 5" white oak	S74°E	25.21
2	" " " " " " 13" hickory	S41°E	30.16
3	" " " " " " 11" "	S 9°E	43.55
4	" " " " " " 6" "	S45° ± W	44.14

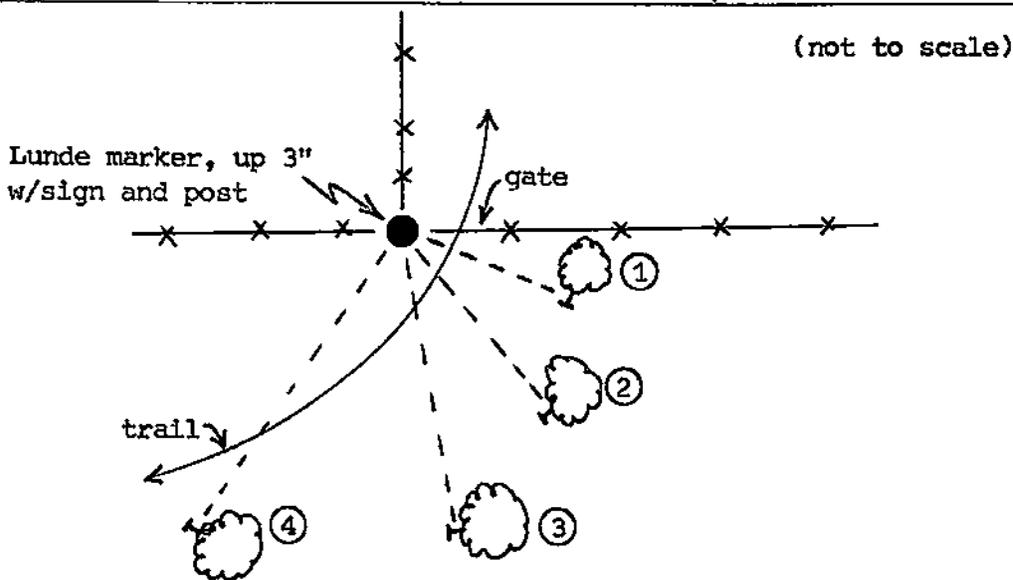

PLAN VIEW DRAWING OF REFERENCE TIES

MAP SHOWING DISTANCE AND DIRECTION TO OTHER PUBLIC LAND SURVEY CORNERS USED FOR REESTABLISHING THE CORNER

(not to scale)

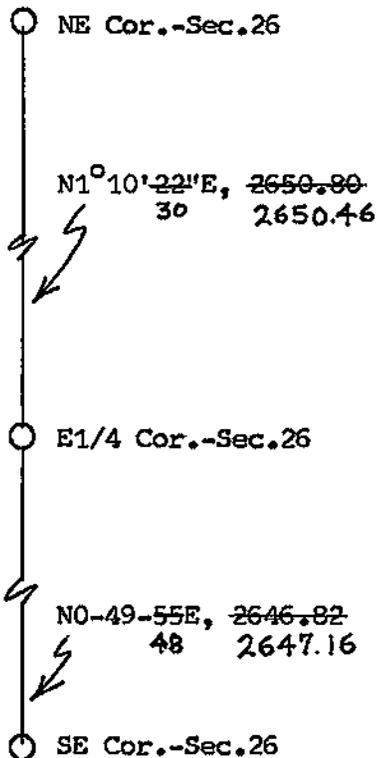


I, William C. Jung, Deputy County Surveyor,  
HEREBY CERTIFY THAT THE CORNER LOCATION SHOWN ON THIS RECORD  
WAS DETERMINED BY ME OR UNDER MY DIRECTION AND CONTROL AND  
THAT THIS U. S. PUBLIC LAND SURVEY MONUMENT RECORD IS CORRECT  
AND COMPLETE TO THE BEST OF MY KNOWLEDGE AND BELIEF.

William C. Jung  
Signature

1/20/89  
Date

Revised: 12/28/00 *W.C.J.*

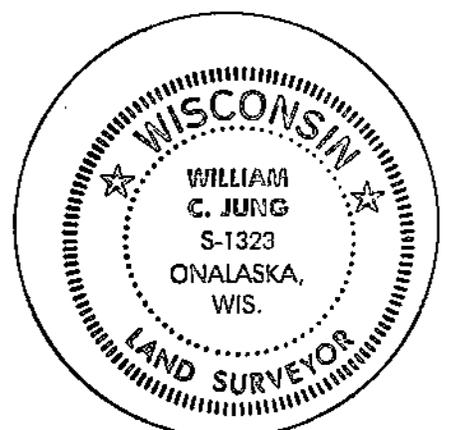

Seal