


21807270020

## U. S. PUBLIC LAND SURVEY MONUMENT RECORD

SECTION 27 T 18 N, R 7 W, TOWN OF Farmington

LA CROSSE COUNTY

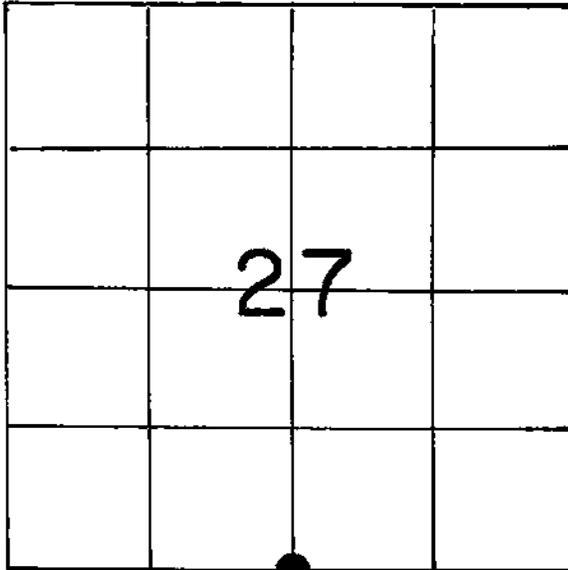

LOCATION OF LANDMARK

Crew: William C. Jung  
Peter Follansbee

Date: 10/28/88

Describe any record evidence, monument evidence, testimonial evidence or any other material evidence you considered and whether the monument was found or restored through acceptance of an obliterated evidence location.

I found what I believe to be an original bearing tree to the Southeast and set the corner off this tree. Norm Hurlburt agrees with this. I set a brass capped Lunde marker at the corner, about 3' West of the fence. As a memorial, I buried a whiskey bottle on the Southeast side of the Lunde marker. There is a blank bullet in the bottle.

Describe or show any material discrepancy between the location of the restored corner and that of the corner previously restored or reestablished.

None known.

## WISCONSIN COORDINATE SYSTEM

North

East

Theta Angle

Horiz. Order

Vert. Order


## TYPE OF LANDMARK

Brass capped Lunde marker

BEARINGS ARE REFERENCED TO

RECORD OF DURABLE WITNESS MONUMENTS

NO	DESCRIPTION	BEARING	DISTANCE
1	P.K. nail in double blazed poplar, 16", 2' East of the fence	-----	20.43
2	P.K. nail in 15" white oak, double blazed on both sides, 2.5' South and 3' East of corner	-----	4.20
3	P.K. nail in double blazed 10" oak, 15' East of fence	-----	32.82
4	P.K. nail in single blazed 27" white oak (original) Magnetic = N83°W	-----	58.62

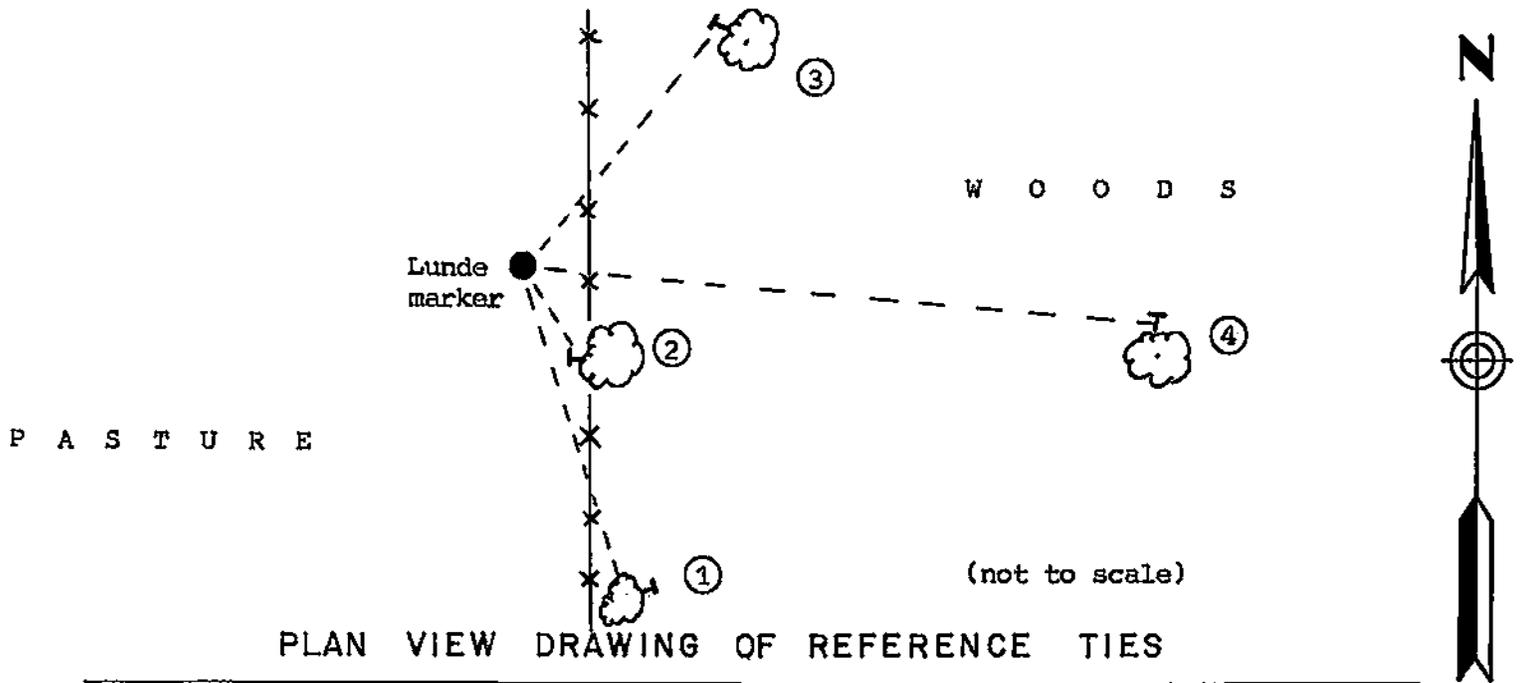


PLAN VIEW DRAWING OF REFERENCE TIES

MAP SHOWING DISTANCE AND DIRECTION TO OTHER PUBLIC LAND SURVEY CORNERS USED FOR REESTABLISHING THE CORNER

(No section measurements were made by me at this time. The section was "run out" by Norm Hurlburt.)

I, William C. Jung, Deputy County Surveyor,  
 HEREBY CERTIFY THAT THE CORNER LOCATION SHOWN ON THIS RECORD  
 WAS DETERMINED BY ME OR UNDER MY DIRECTION AND CONTROL AND  
 THAT THIS U. S. PUBLIC LAND SURVEY MONUMENT RECORD IS CORRECT  
 AND COMPLETE TO THE BEST OF MY KNOWLEDGE AND BELIEF.

William C. Jung 1/19/89  
 Signature Date

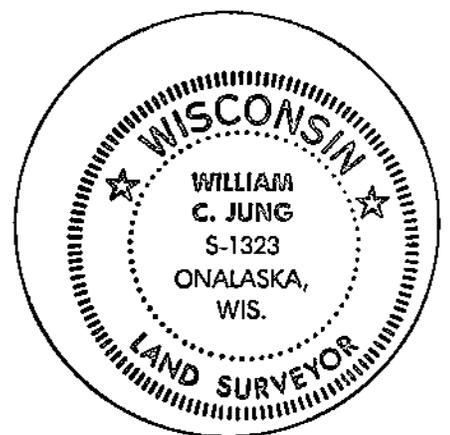

Seal