


21807272000

## U. S. PUBLIC LAND SURVEY MONUMENT RECORD

SECTION 26 T 18 N, R 7 W, TOWN OF Farmington

LA CROSSE COUNTY

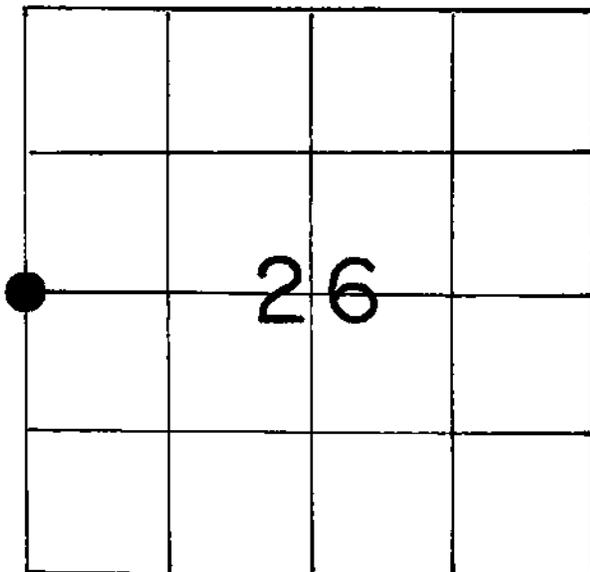

LOCATION OF LANDMARK

Crew: William C. Jung  
Peter Follansbee

Date: 9/23/88

Describe any record evidence, monument evidence, testimonial evidence or any other material evidence you considered and whether the monument was found or restored through acceptance of an obliterated evidence location.

Norm Hurlburt and I found evidence of the old occupied corner and accepted this as the best available evidence of the original government corner position. I monumented the corner with a brass capped Lunde marker and buried a whiskey bottle with a blank bullet as a memorial on the East side of the marker.

Describe or show any material discrepancy between the location of the restored corner and that of the corner previously restored or reestablished.

The pipe to the South was used by Phil Scholze and possibly by others as the corner. Hurlburt and I do not agree with this corner.

## WISCONSIN COORDINATE SYSTEM

North

East

Theta Angle

Horiz. Order

Vert. Order

## TYPE OF LANDMARK

Brass capped Lunde marker


## BEARINGS ARE REFERENCED TO

Assumed

RECORD OF DURABLE WITNESS MONUMENTS  
Magnetic

NO	DESCRIPTION	BEARING	DISTANCE
1	P.K. nail in unblazed 3" hickory	S17°E	22.21
2	Existing iron pipe	S 5°E	15.05
3	P.K. nail in unblazed 4" oak	S38°W	15.53
4	P.K. nail in double blazed 20" hickory	N44°E	21.51


(not to scale)

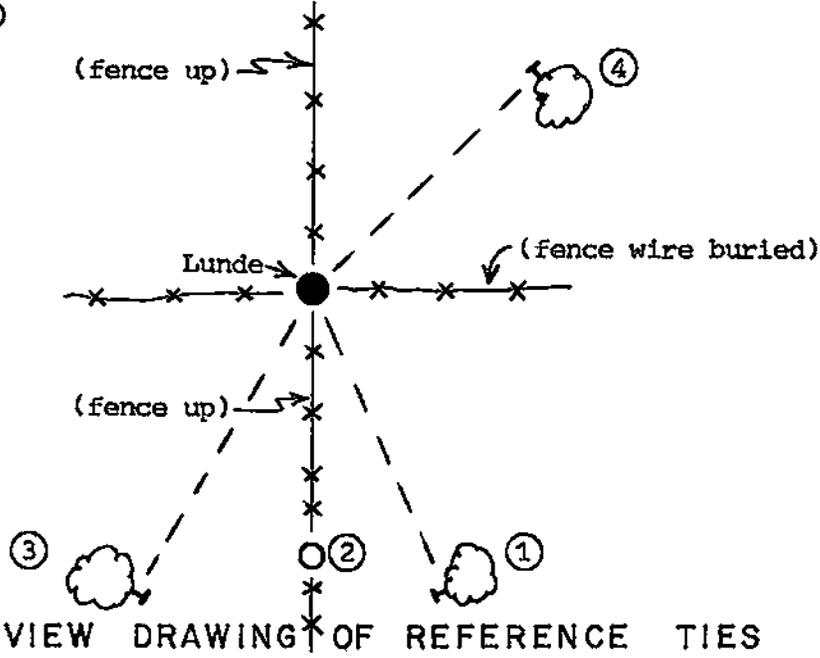

PLAN VIEW DRAWING OF REFERENCE TIES

MAP SHOWING DISTANCE AND DIRECTION TO OTHER PUBLIC LAND SURVEY CORNERS USED FOR REESTABLISHING THE CORNER

(not to scale)

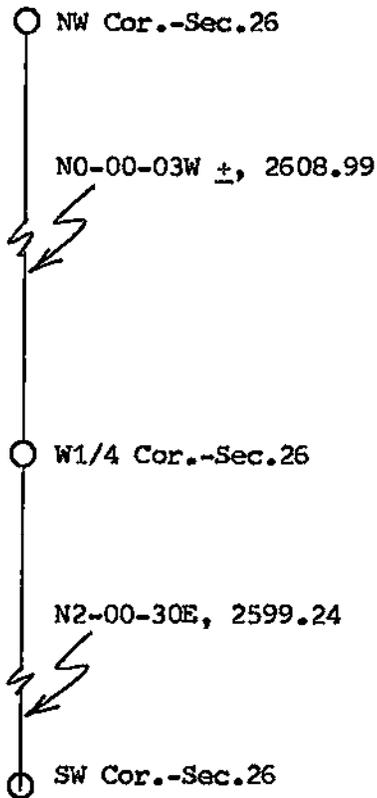

I, William C. Jung, Deputy County Surveyor,  
HEREBY CERTIFY THAT THE CORNER LOCATION SHOWN ON THIS RECORD  
WAS DETERMINED BY ME OR UNDER MY DIRECTION AND CONTROL AND  
THAT THIS U. S. PUBLIC LAND SURVEY MONUMENT RECORD IS CORRECT  
AND COMPLETE TO THE BEST OF MY KNOWLEDGE AND BELIEF.

William C. Jung  
Signature

1/20/89  
Date



Seal