


U. S. PUBLIC LAND SURVEY MONUMENT RECORD

SECTION 27 T 18 N, R 7 W, TOWN OF Farmington

LA CROSSE COUNTY

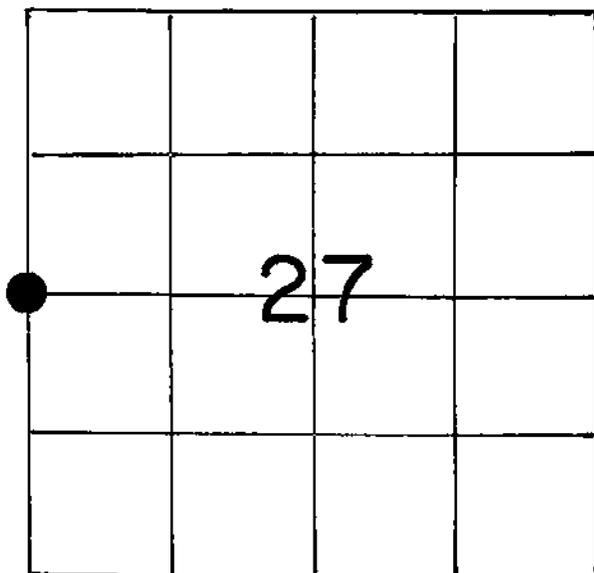

LOCATION OF LANDMARK

WISCONSIN COORDINATE SYSTEM
North
East
Theta Angle
Horiz. Order
Vert. Order
TYPE OF LANDMARK
Brass capped Lunde marker
BEARINGS ARE REFERENCED TO

Crew: William C. Jung
Peter Follansbee

Date: 9/20/88

Describe any record evidence, monument evidence, testimonial evidence or any other material evidence you considered and whether the monument was found or restored through acceptance of an obliterated evidence location.


Norm Hurlburt set this Lunde at the corner. I found old North-South wire, some of which was buried, at the corner. The "tie-off" wire fits the corner position. I agree with Hurlburt's placement of this corner. As a memorial, I buried a whiskey bottle with a blank bullet on the East side of the marker. I set a stone over the bottle. I also set more stones near the marker. The corner is on a steep slope on the North side of the ridge.

Describe or show any material discrepancy between the location of the restored corner and that of the corner previously restored or reestablished.

None known.

RECORD OF DURABLE WITNESS MONUMENTS
Magnetic

NO	DESCRIPTION	BEARING	DISTANCE
1	P.K.nail in single blazed 23" white oak	N28°W	24.58
2	" " " " " 18" " "	N77°W	24.78
3	To the center of an unblazed 3½" hickory	S73°W	31.05
4	P.K.nail in single blazed 16" white oak	S65°W	slope=42.51

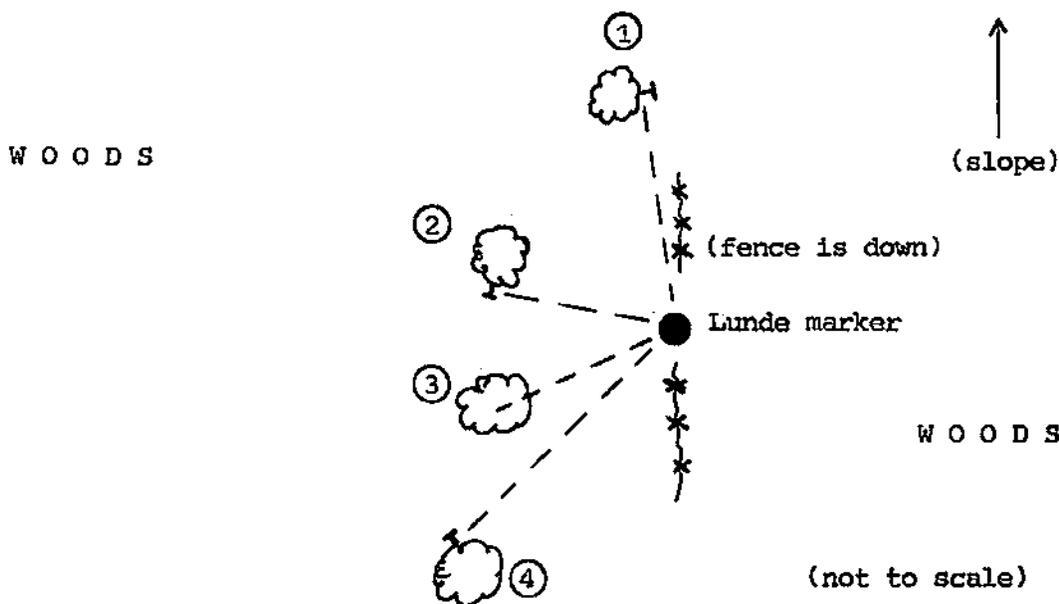

PLAN VIEW DRAWING OF REFERENCE TIES




MAP SHOWING DISTANCE AND DIRECTION TO OTHER PUBLIC LAND SURVEY CORNERS USED FOR REESTABLISHING THE CORNER

(No section measurements were made by me at this time. The section was "run out" by Norm Hurlburt.)

I, William C. Jung, Deputy County Surveyor,
HEREBY CERTIFY THAT THE CORNER LOCATION SHOWN ON THIS RECORD WAS DETERMINED BY ME OR UNDER MY DIRECTION AND CONTROL AND THAT THIS U. S. PUBLIC LAND SURVEY MONUMENT RECORD IS CORRECT AND COMPLETE TO THE BEST OF MY KNOWLEDGE AND BELIEF.

William C. Jung 1/19/89
Signature Date

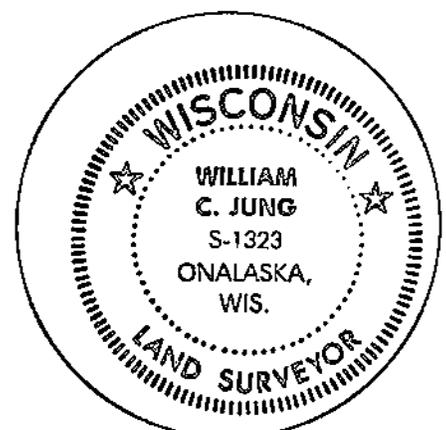

Seal